

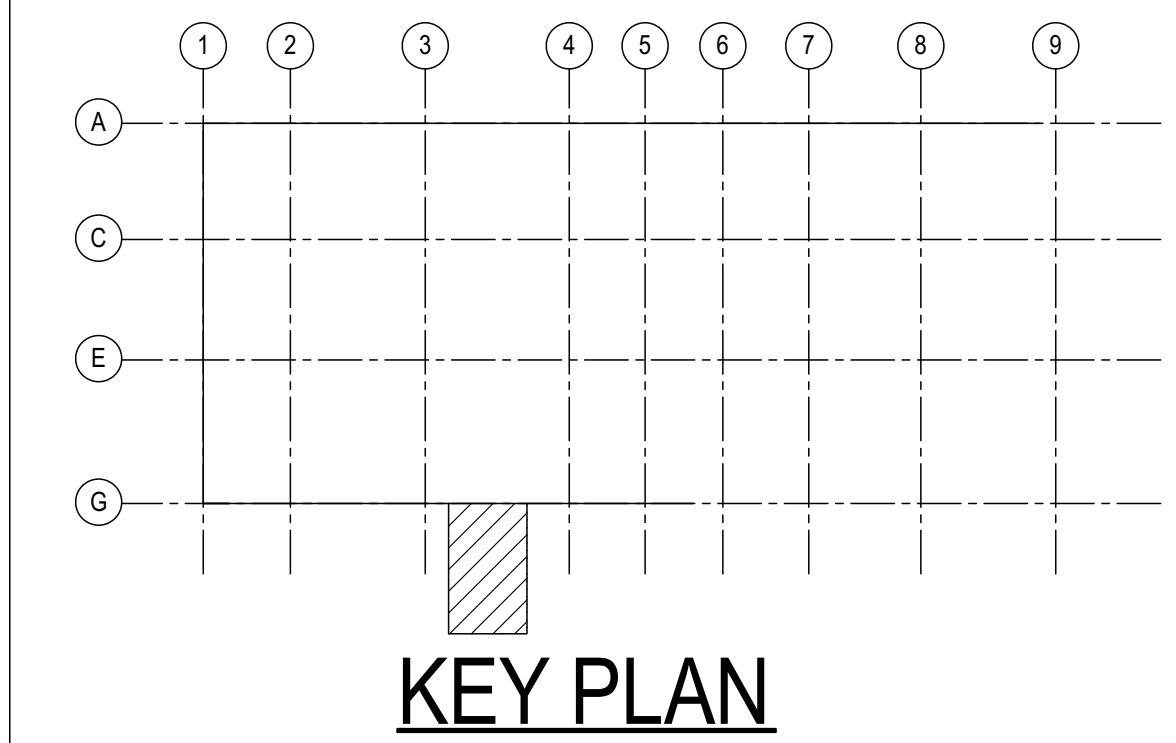
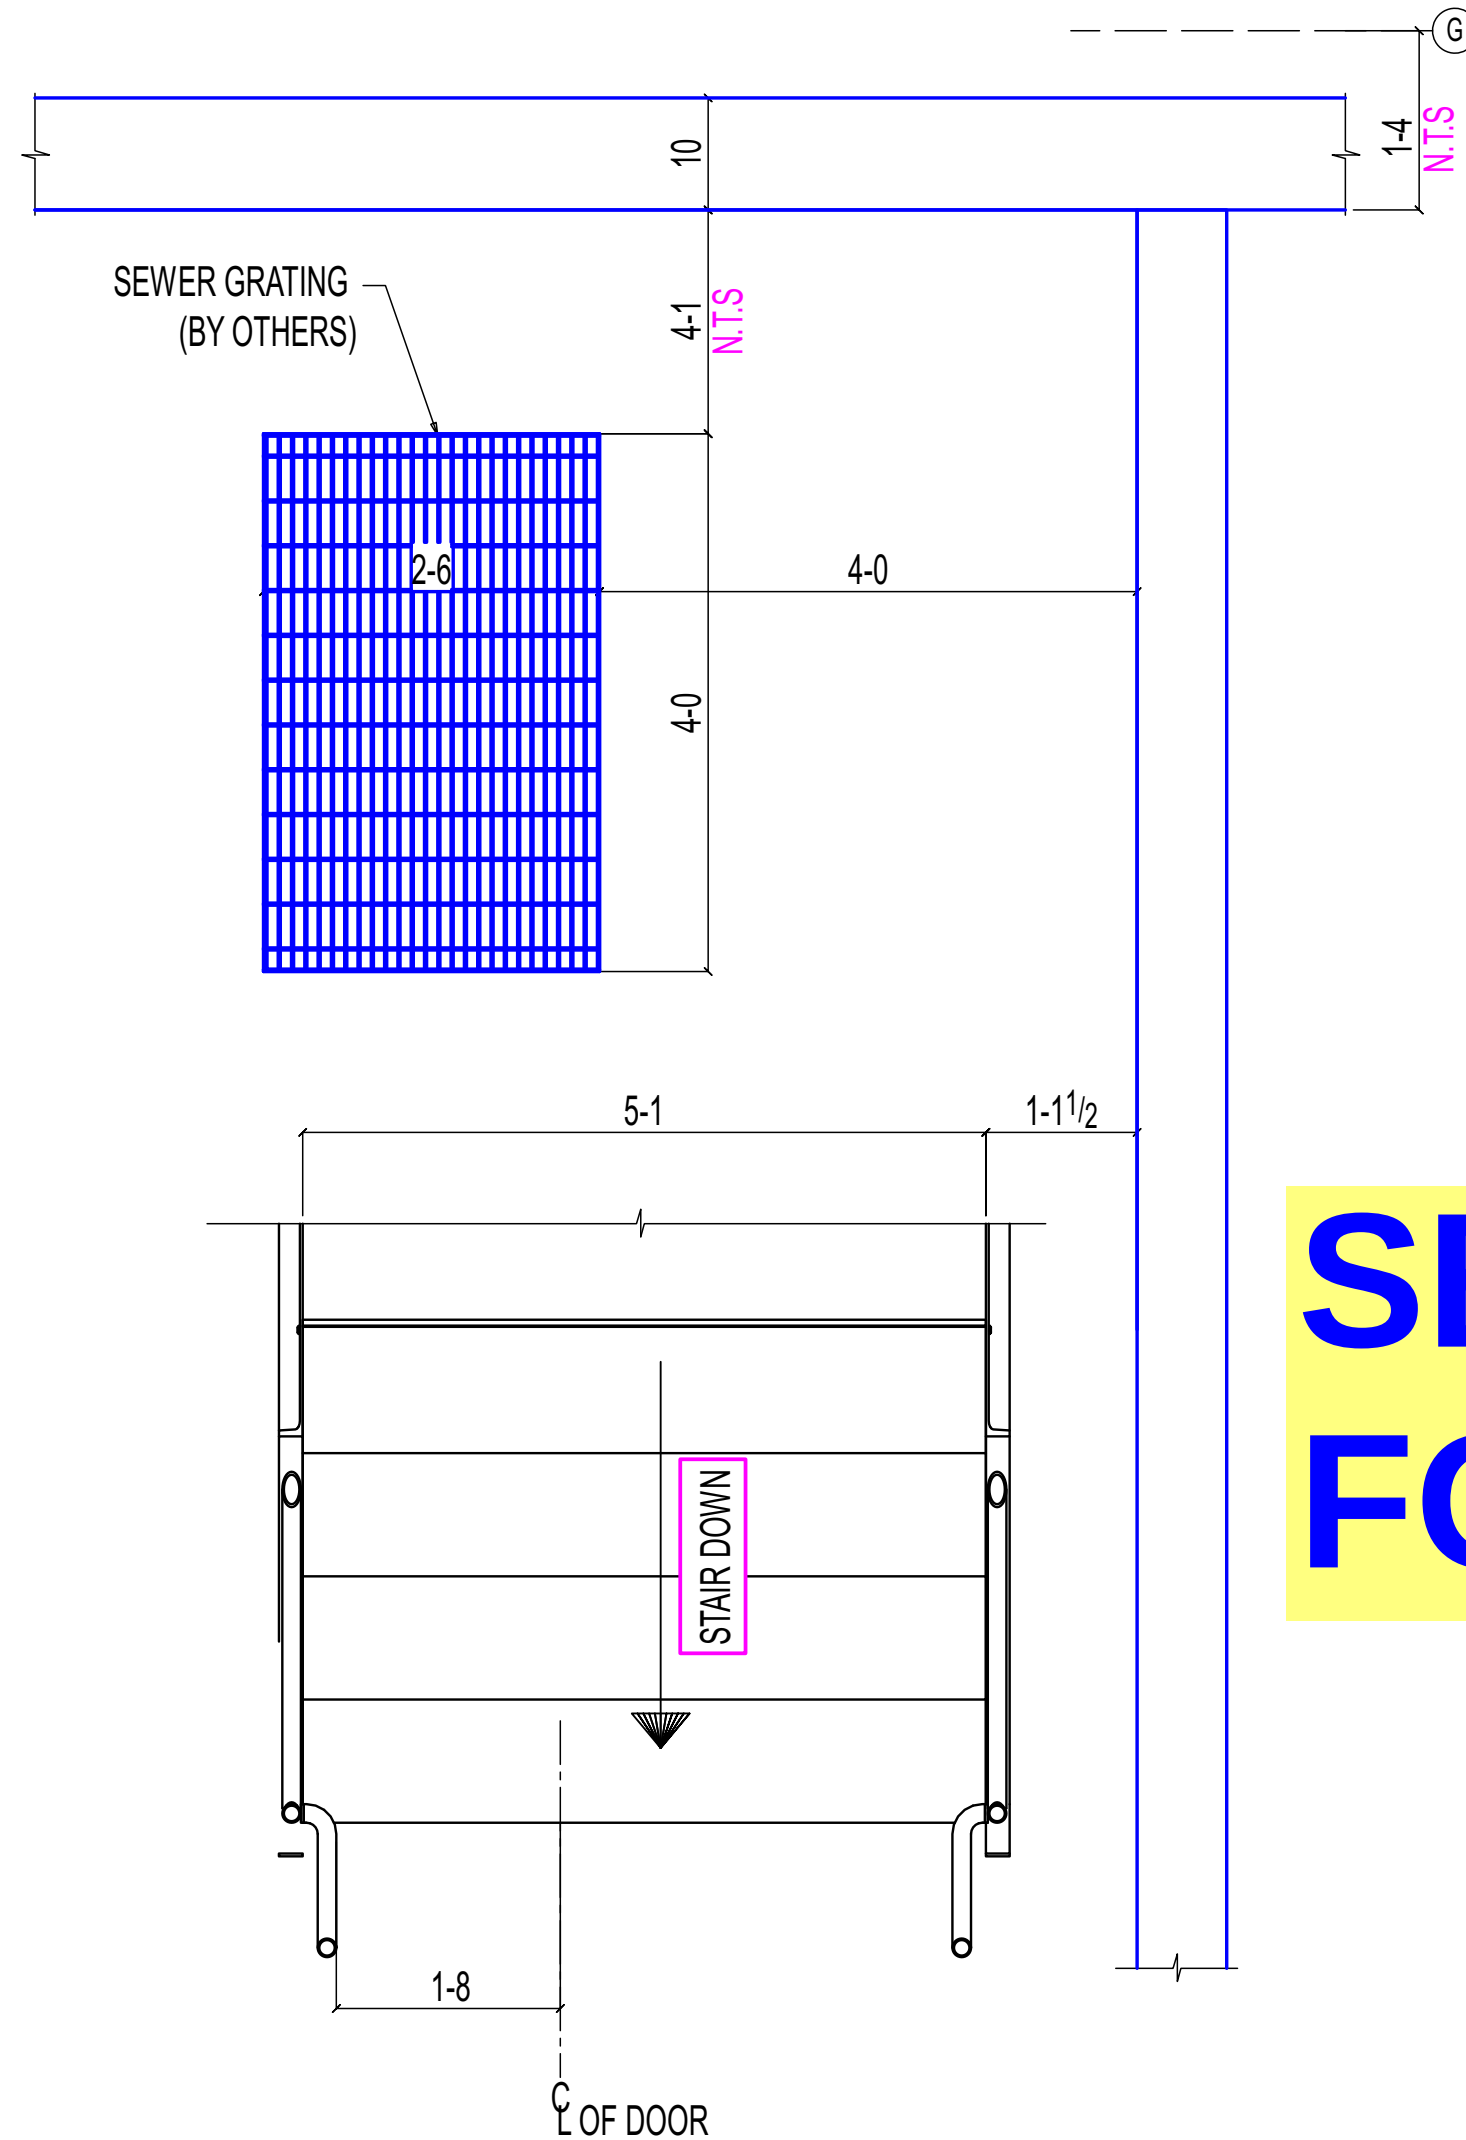


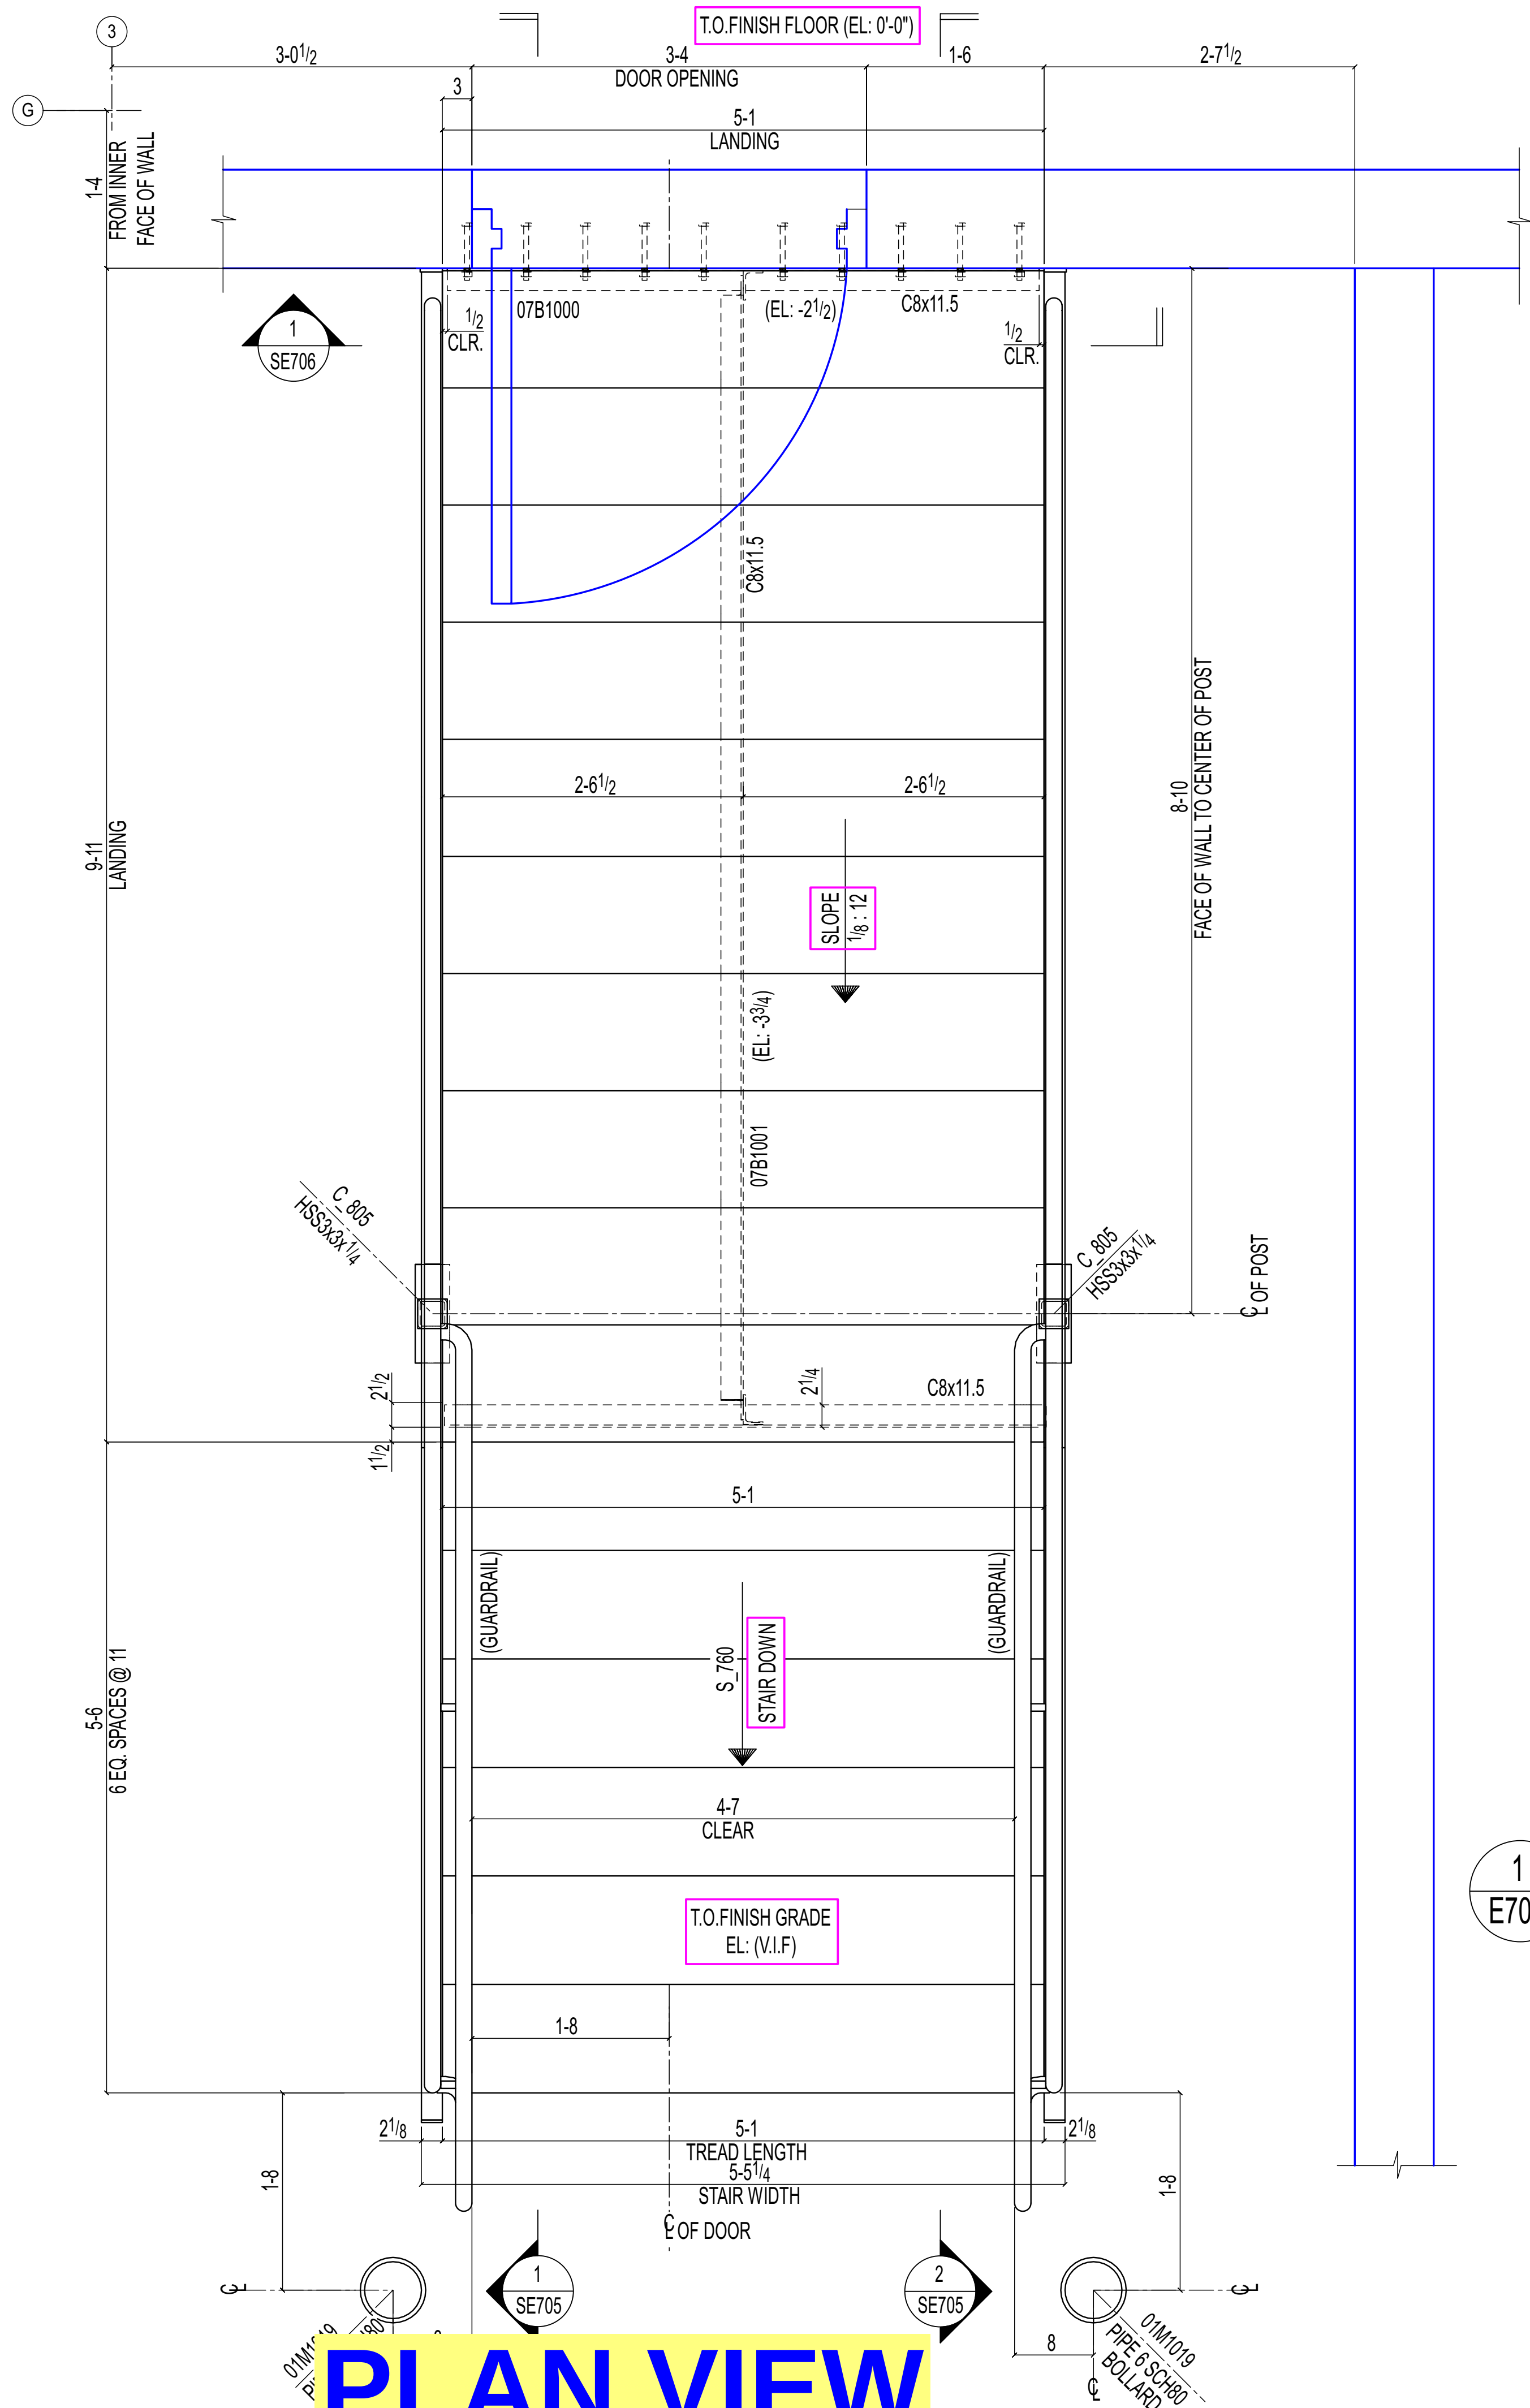


2 DOCK STAIR PARTIAL FRAMING PLAN
(REF: 1/A101,14/A380)
OTHERS NOT SHOWN FOR CLARITY

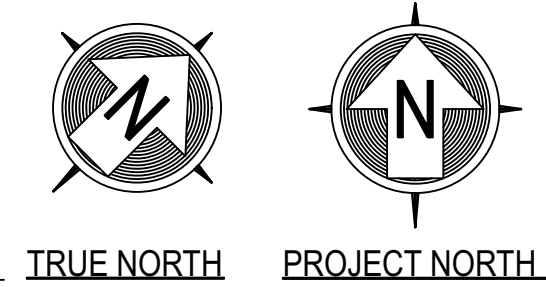

DESCRIPTION	SECTION SIZE
STAIR STRINGER	MC12x14.3
GUARDRAIL	PIPE 1 1/4 SCH40
HANDRAIL	PIPE 1 1/4 SCH40
GUARDRAIL POST	PIPE 1 1/4 SCH80

1 DOCK STAIR FRAMING PLAN
(REF: 1/A101,14/A380)

- NOTE:
1.TOP OF SLAB REFERENCED FROM THE FINISHED FLOOR EL: [0'-0"] = DATUM EL: 100'-0" (U.N.O).
2. ALL STEELS ARE GALVANIZED (U.N.O)

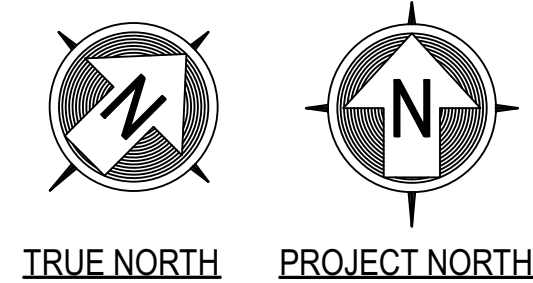


SK#28- Rev-1
02-10-2026

REVISIONS

REV#	DWN BY	DESCRIPTION	DATE
A	SRP	ISSUED FOR APPROVAL	Jun 16 2025

THE INFORMATION NOTED HEREON THIS DRAWING IS THE PROPERTY OF STEEL FAB ENTERPRISES, INC. AND SHALL NOTED BE USED WITHOUT WRITTEN CONSENT.

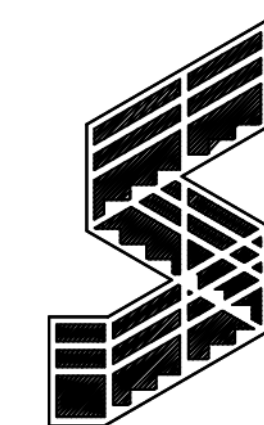


STEEL FAB
ENTERPRISES, LLC

MISCELLANEOUS METALS FABRICATOR AND ERECTORS
623 BAUMGARDNER ROAD, LANCASTER, PA 17603
TEL. (717)464-0330 FAX (717)464-9464
WWW.STEELFABENTERPRISES.COM




PROJECT OWNER : CK CAPITAL, LLC			
PROJECT DESCRIPTION : CLEVELAND BROTHERS-MILESBURG			
PROJECT ADDRESS : 4025N. EAGLE VALLEY ROAD, HOWARD, PA 16841			
CONTRACTOR : KINSLEY CONSTRUCTION, INC.			
DRAWN BY : BAS	DATE : 5-20-25	PROJ. NO. : 25012	REV # 
CHECKED BY : SRP	DATE : 5-20-25	DWG NO. : E702	
DWG DESCRIPTION : DOCK STAIR FRAMING PLAN			

1 ELEVATION VIEW
SE705
(REF: 15/A380)
OTHER NOT SHOWN FOR CLARITY

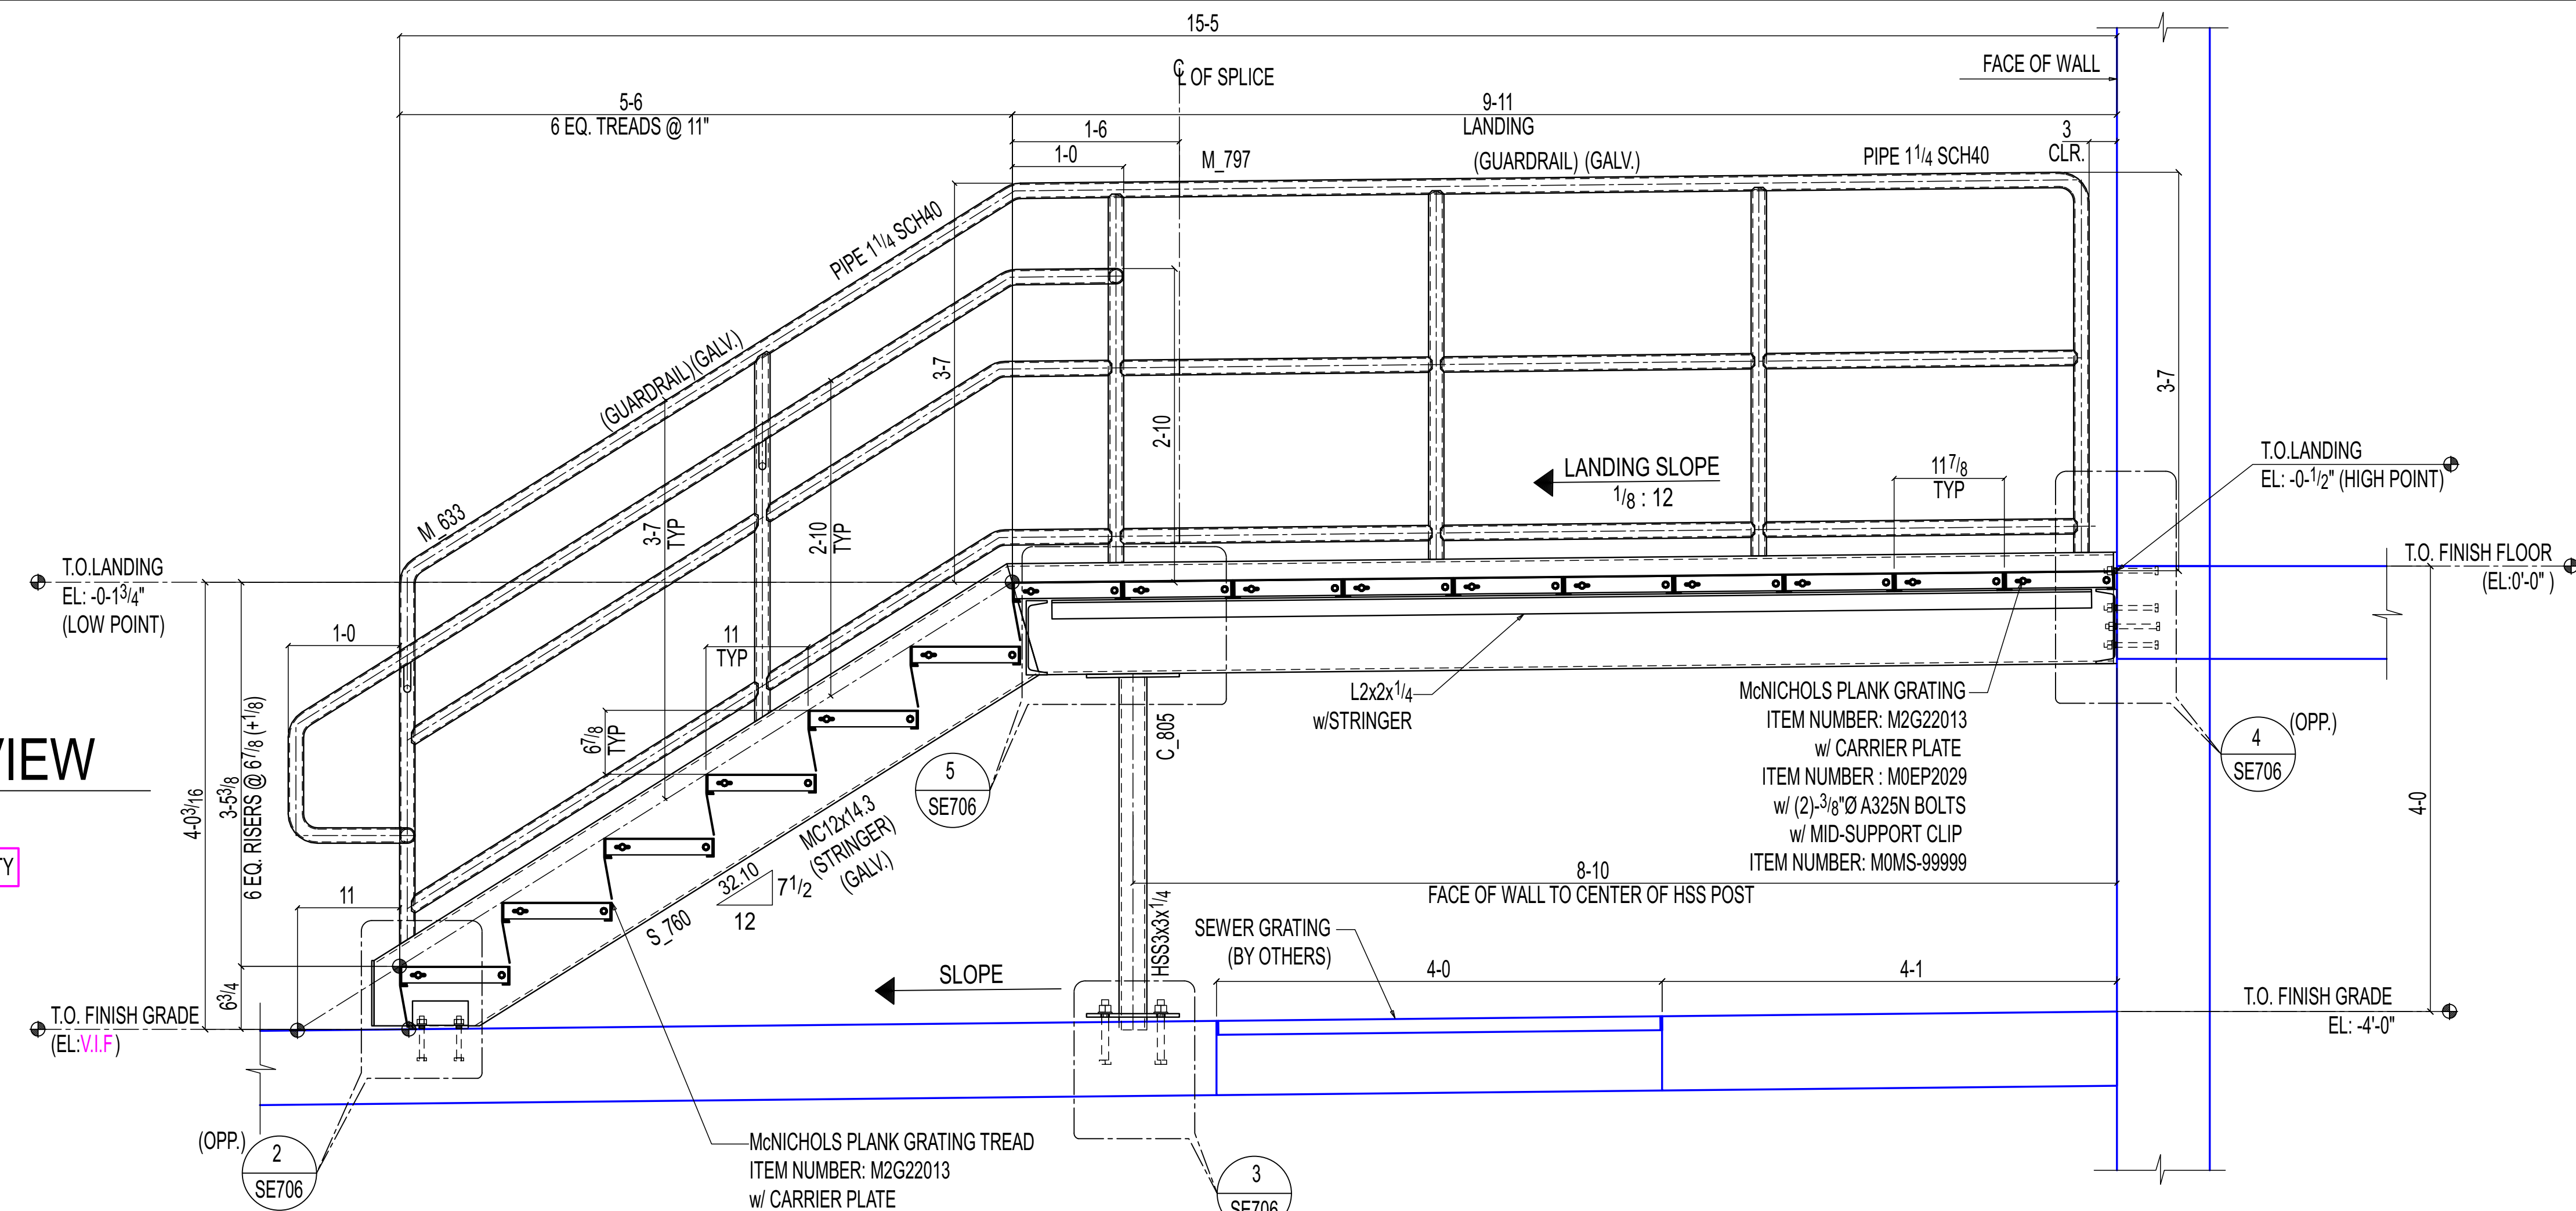

ERECTOR NOTE:
1. WIRE BRUSH GALVANIZED SURFACE AS REQUIRED FOR WELDING.
2. TOUCHUP ALL FIELD WELDS WITH ZINC RICH PAINT (U.N.O)

(10)-11 7/8" McNICHOLS planks

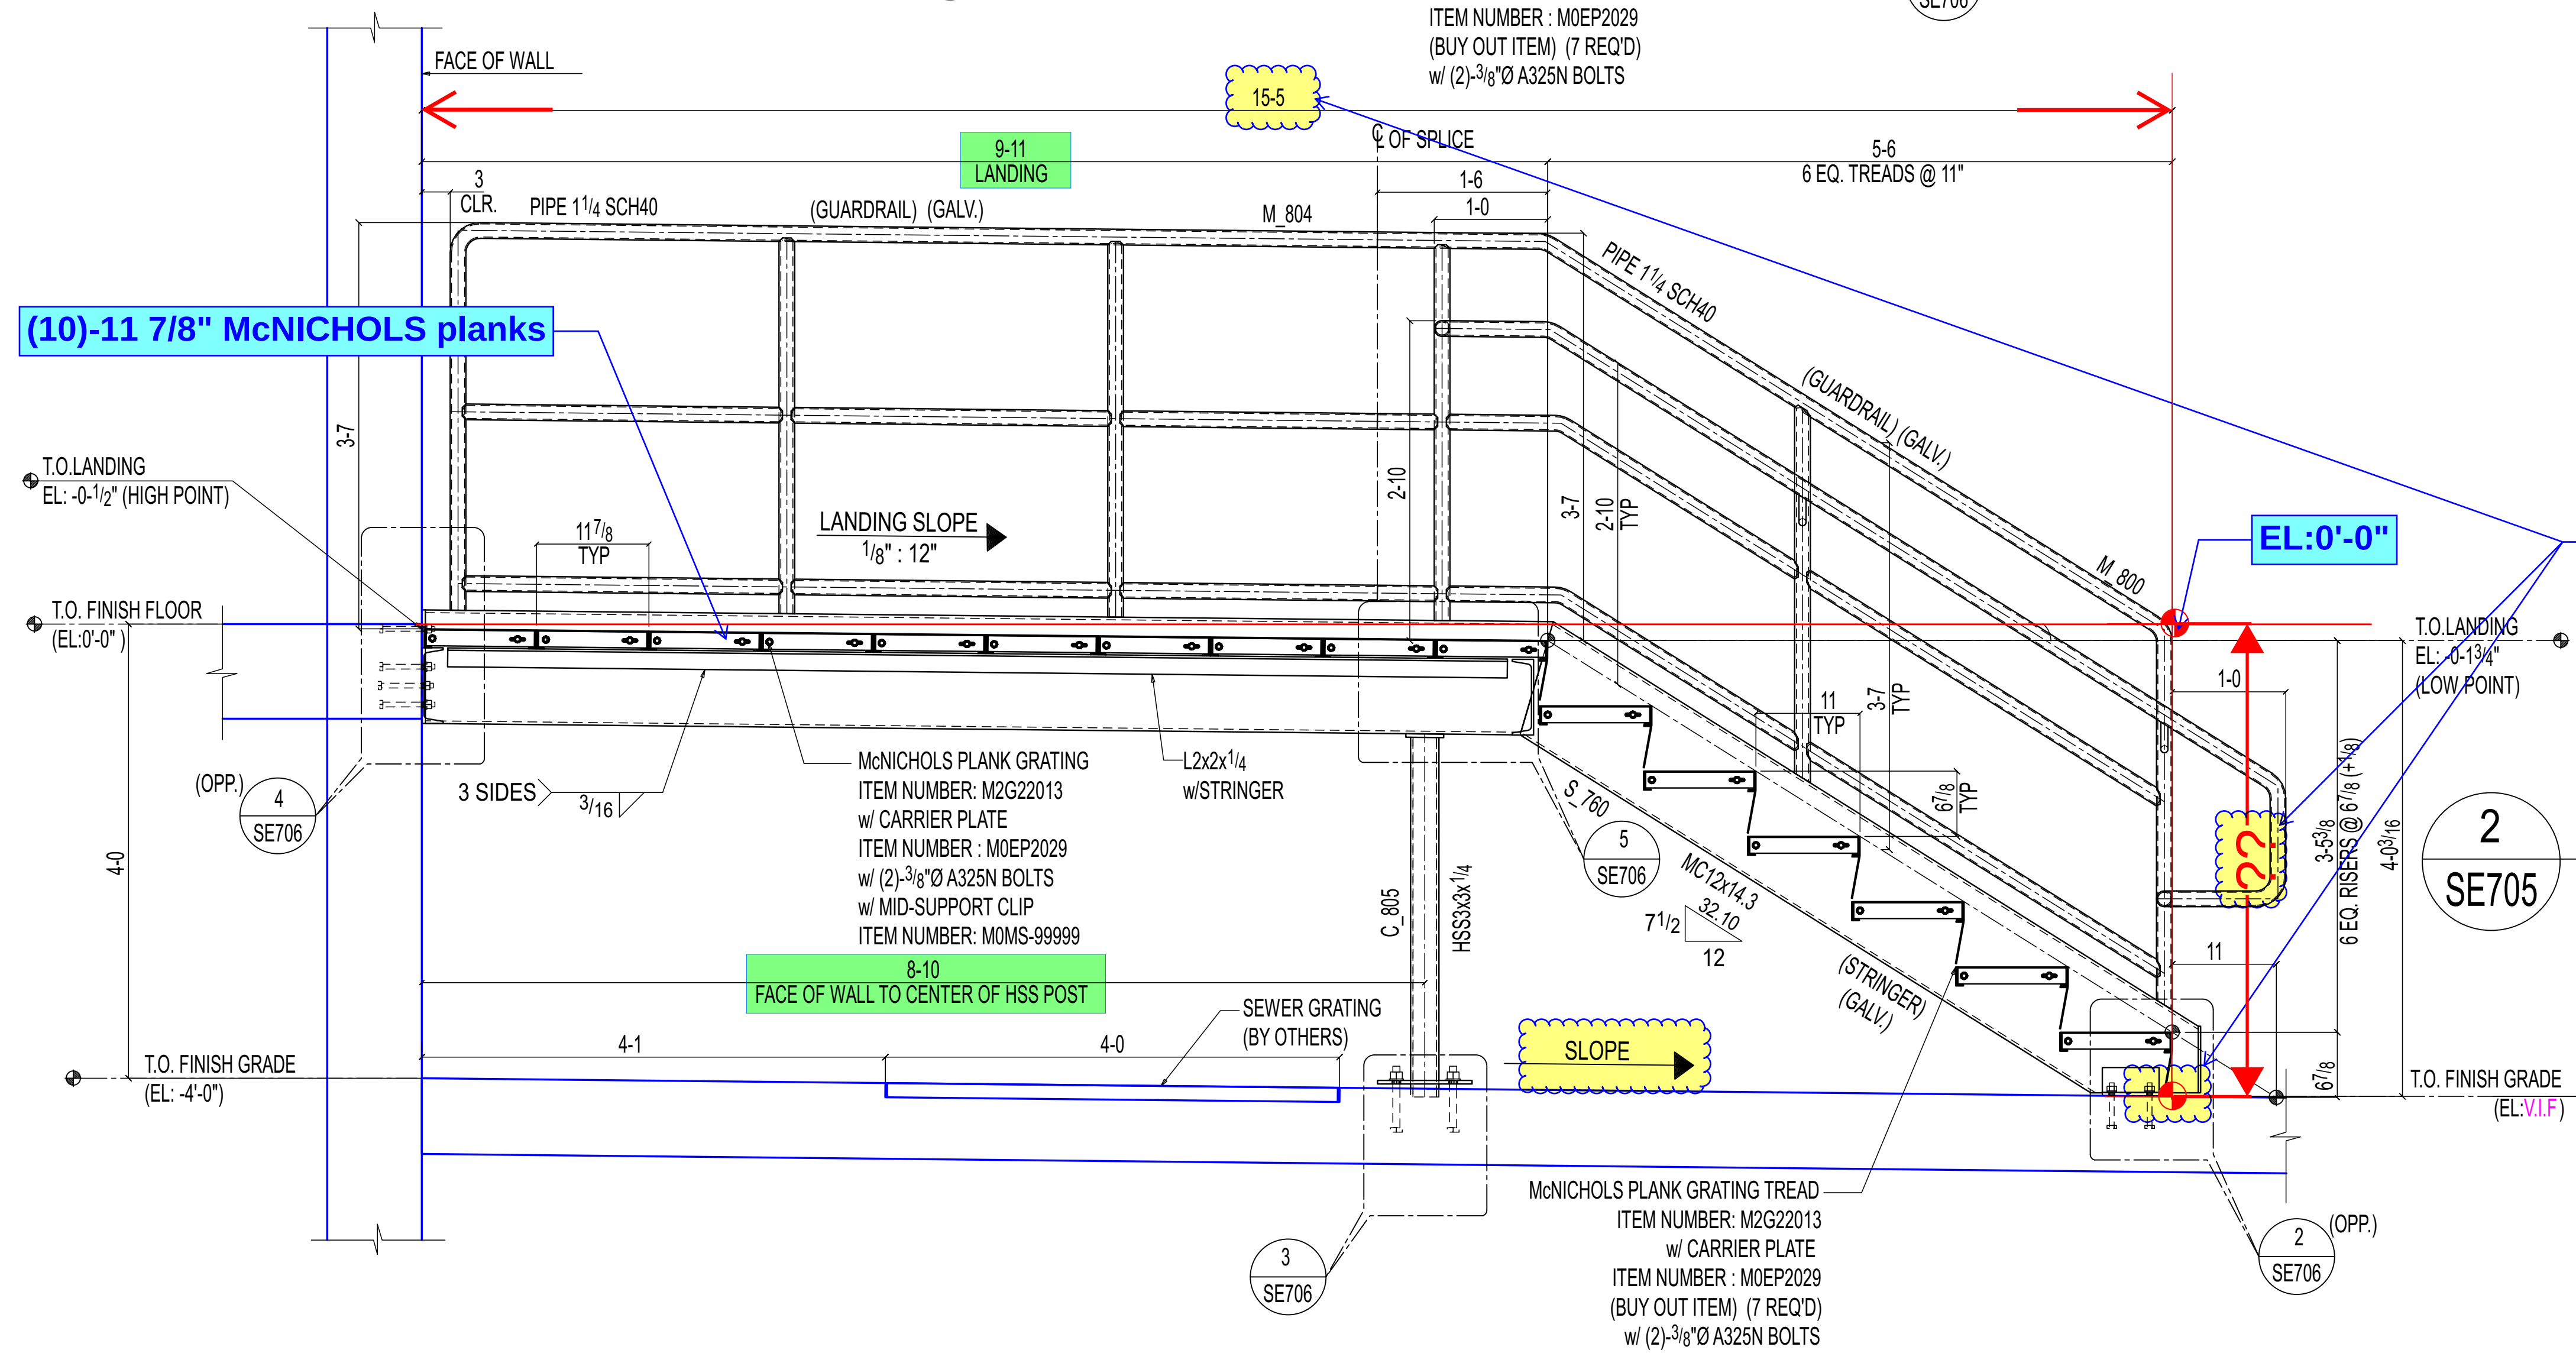

Q1

We have followed the (10) qty of 11 7/8" wide planks and increased the landing length to 9'-11".

Additionally, we need the top of bottom (landing)slab elevation at the yellow clouded location, which is 15'-5" from the face of wall as marked.

Please provide the elevation ASAP then only we can able to send the stair to fabrication.

2 ELEVATION VIEW
SE705
(REF: 15/A380)
OTHER NOT SHOWN FOR CLARITY

SK#28- Rev-1
02-10-2026

STEEL FAB ENTERPRISES, LLC
MISCELLANEOUS METALS FABRICATOR AND ERECTORS
623 BAUMGARDNER ROAD, LANCASTER, PA 17603
TEL. (717)464-0330 FAX (717)464-9464
WWW.STEELFABENTERPRISES.COM

PROJECT OWNER : CK CAPITAL, LLC
PROJECT DESCRIPTION : CLEVELAND BROTHERS-MILESBURG
PROJECT ADDRESS : 4025N. EAGLE VALLEY ROAD, HOWARD, PA 16841
ERECTOR : KINSLEY CONSTRUCTION, INC.

BY: BAS	DATE: 5-20-25	PROJ. NO.: 25012	REV #
BY: SRP	DATE: 5-20-25	DWG NO.: SE705	△

DWG DESCRIPTION : STAIR ELEVATION VIEW