
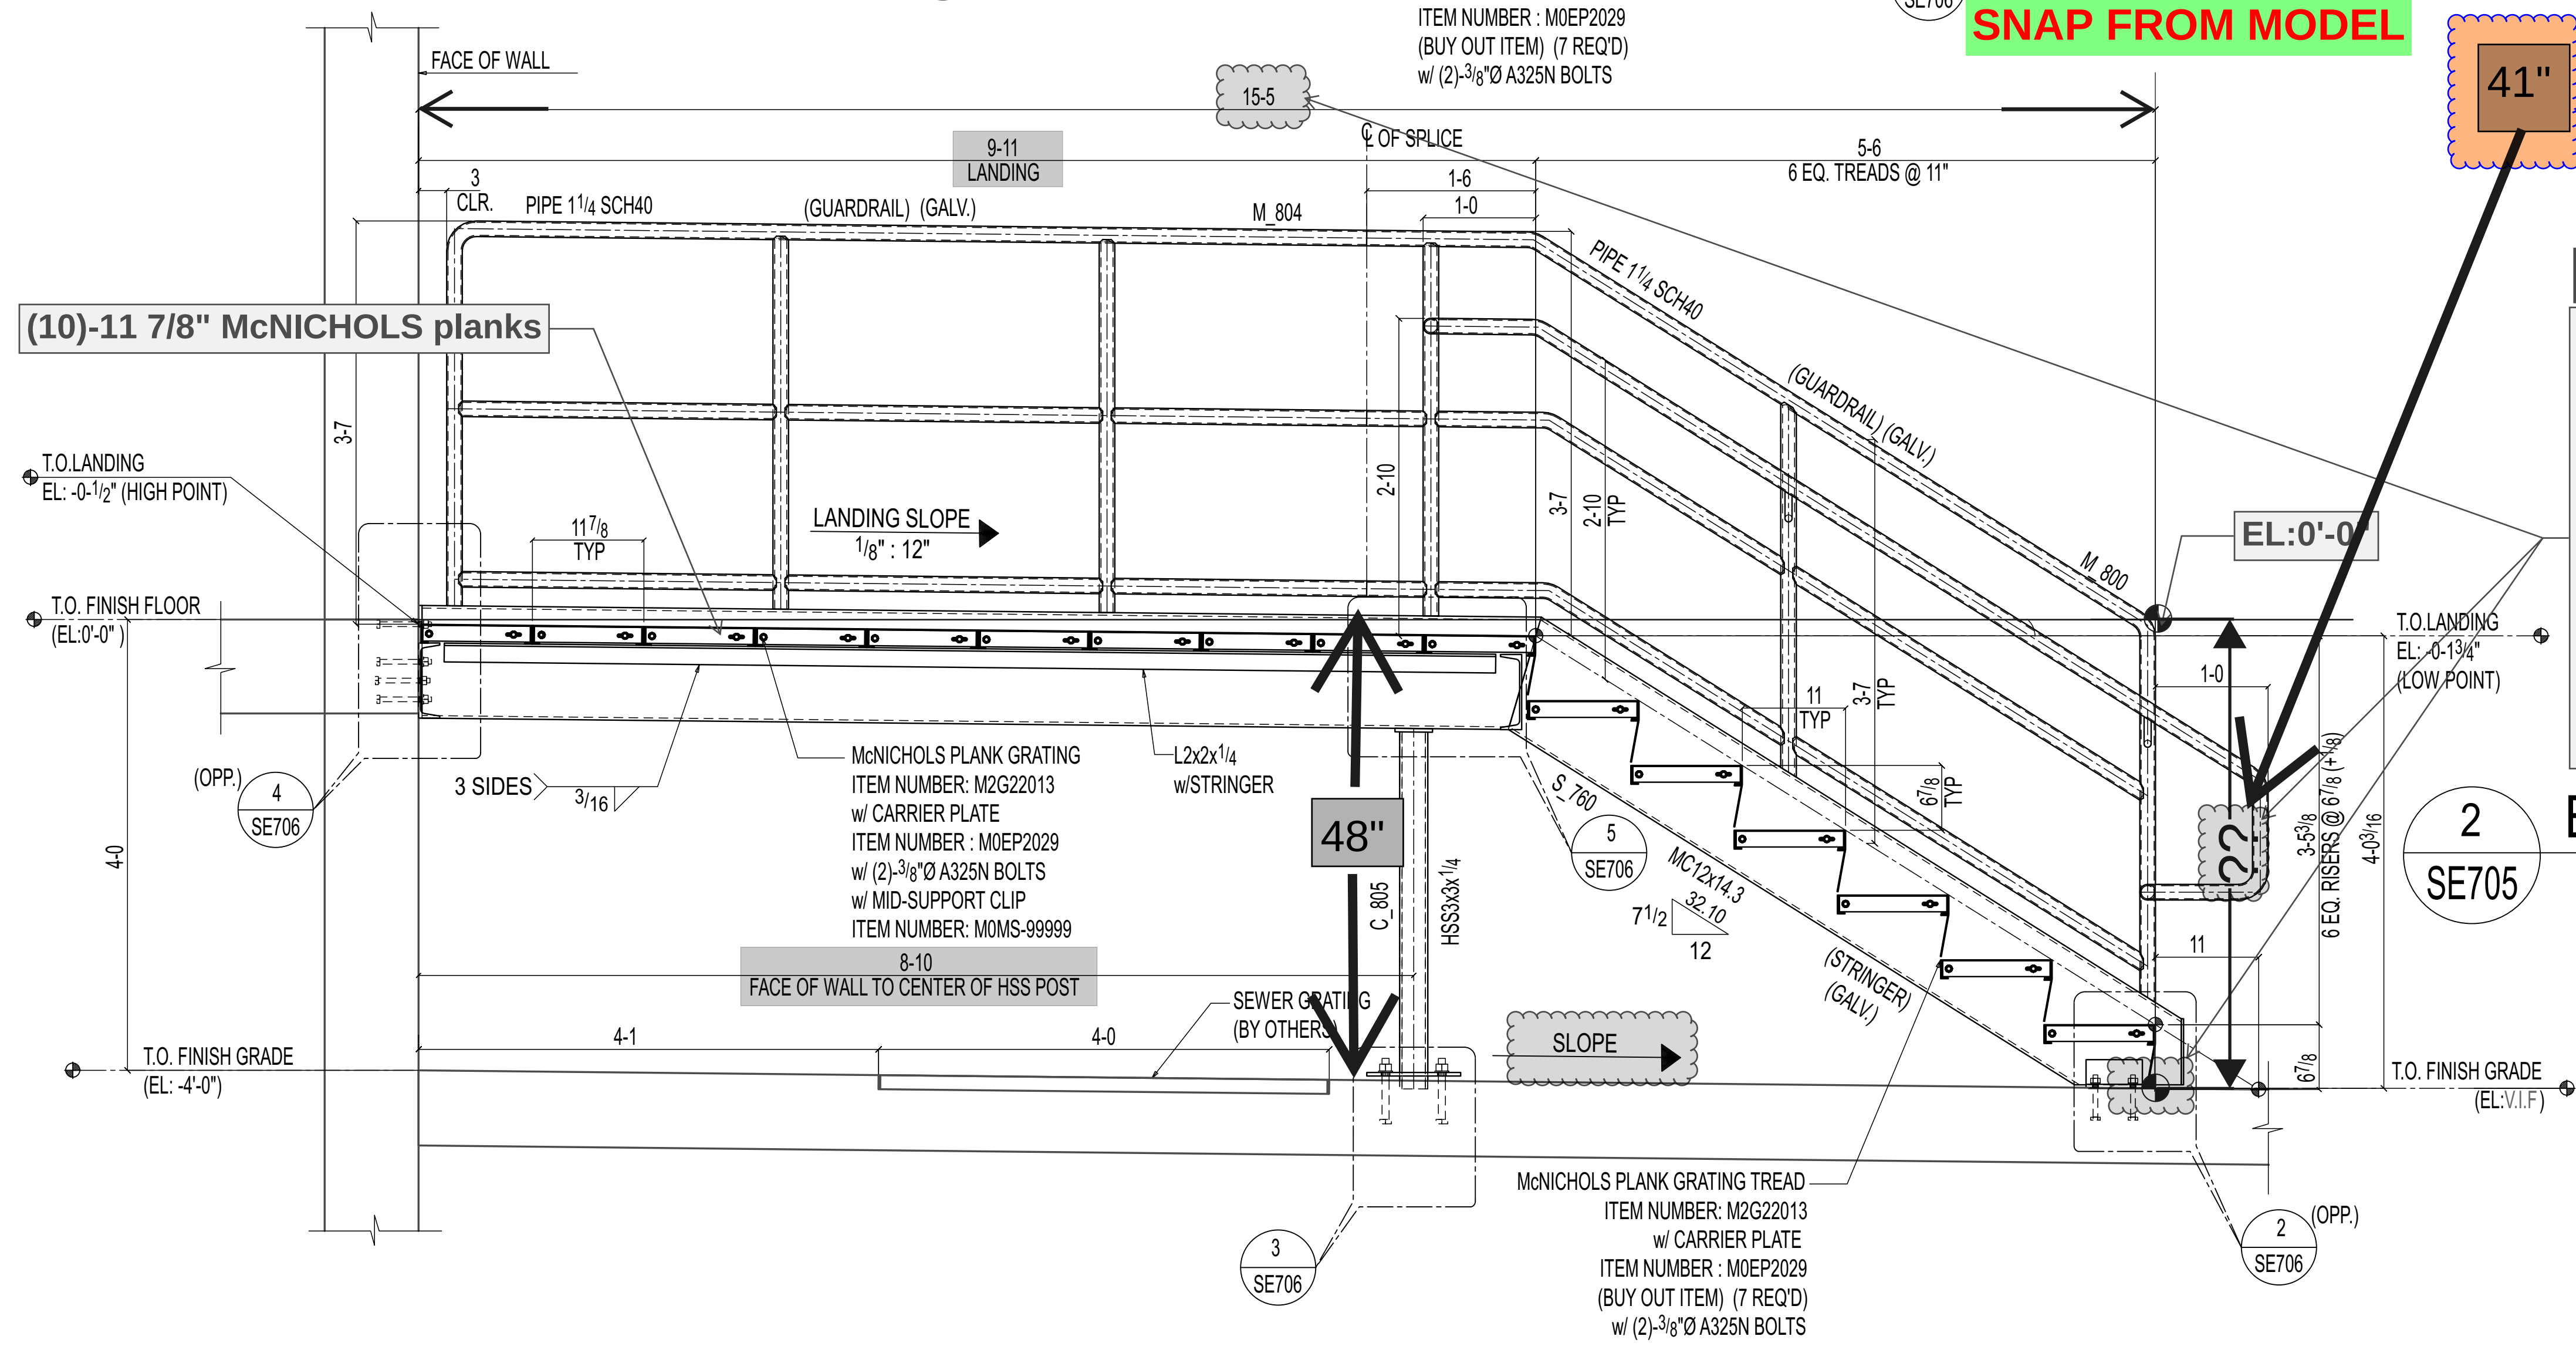


1 ELEVATION VIEW
SE705
(REF: 15/A380)
OTHER NOT SHOWN FOR CLARITY

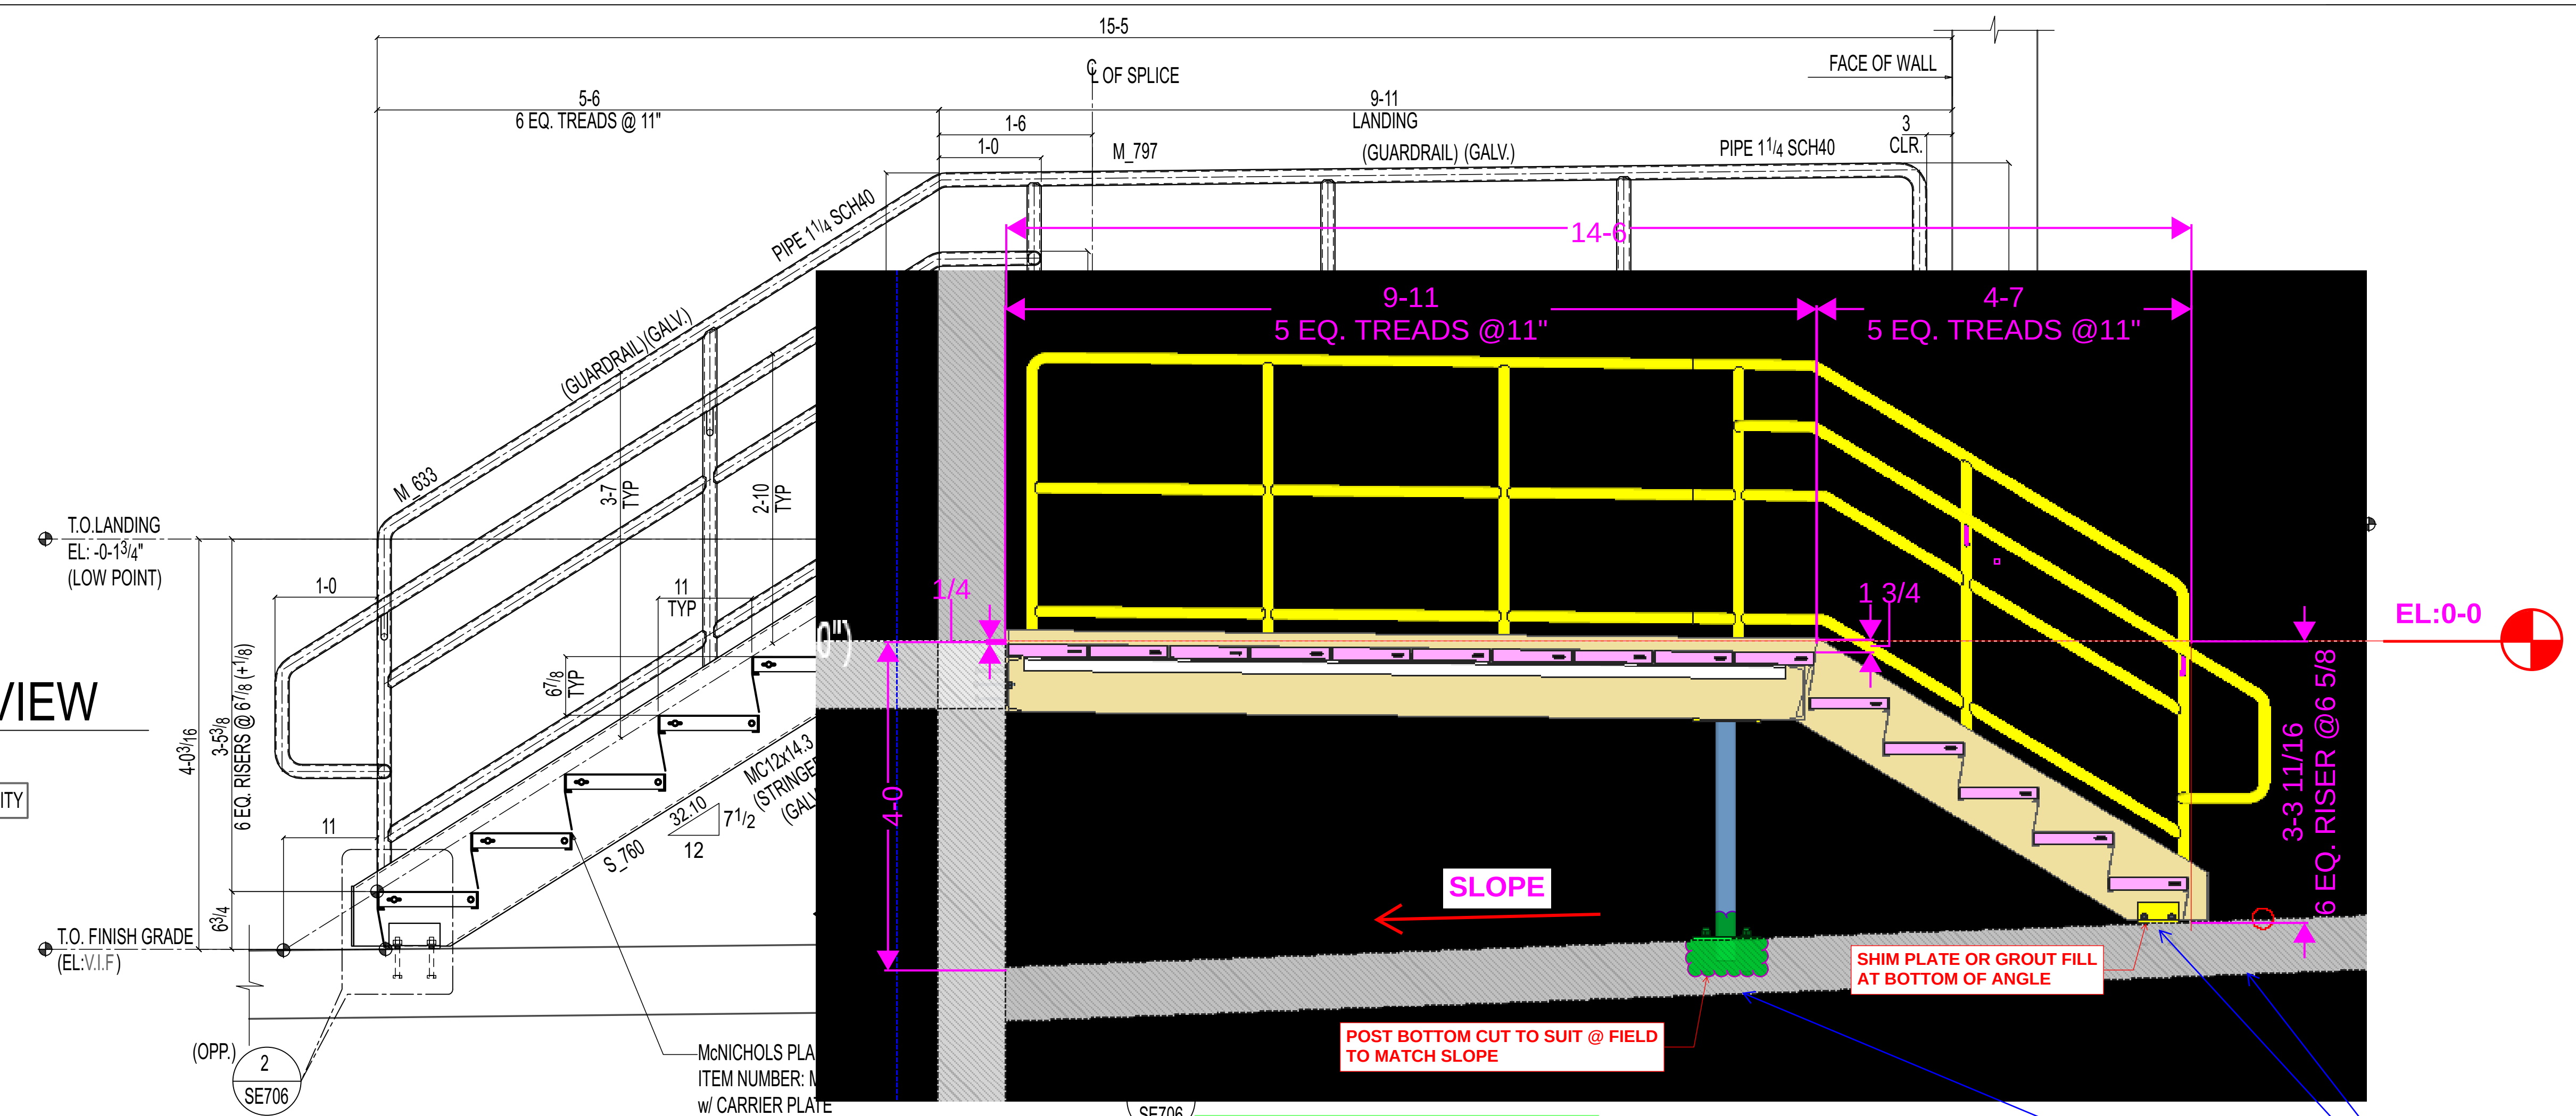

SNAP FROM MODEL

41"

Q1
We have followed field measurements and maintained an overall dock stair length of 14'-6". Kindly confirm if it is okay to proceed?

Q1
Additionally, we have provided grout at the bottom connection angle. The post will be field-cut as required, with grout filling applied accordingly. Please advise.


Please provide the elevation ASAP then only we can able to send the stair to fabrication.

Q1
We have followed field measurements and maintained an overall dock stair length of 14'-6". Kindly confirm if it is okay to proceed?

Q1
Additionally, we have provided grout at the bottom connection angle. The post will be field-cut as required, with grout filling applied accordingly. Please advise.

ERECTOR NOTE:
1. WIRE BRUSH GALVANIZED SURFACE AS REQUIRED FOR WELDING.
2. TOUCHUP ALL FIELD WELDS WITH ZINC RICH PAINT (U.N.O)

2 ELEVATION VIEW
SE705
(REF: 15/A380)
OTHER NOT SHOWN FOR CLARITY

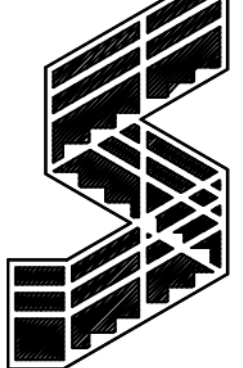

STEEL FAB ENTERPRISES, LLC
MISCELLANEOUS METALS FABRICATOR AND ERECTORS
623 BAUMGARDNER ROAD, LANCASTER, PA 17603
TEL. (717)464-0330 FAX (717)464-9464
WWW.STEELFABENTERPRISES.COM

PROJECT OWNER : CK CAPITAL, LLC
PROJECT DESCRIPTION : CLEVELAND BROTHERS-MILESBURG
PROJECT ADDRESS : 4025N. EAGLE VALLEY ROAD, HOWARD, PA 16841
ERECTOR : KINSLEY CONSTRUCTION, INC.

BY: BAS	DATE: 5-20-25	PROJ. NO.: 25012	REV #
BY: SRP	DATE: 5-20-25	DWG NO.: SE705	A

DWG DESCRIPTION : STAIR ELEVATION VIEW

SK#28- Rev-2
02-13-2026