


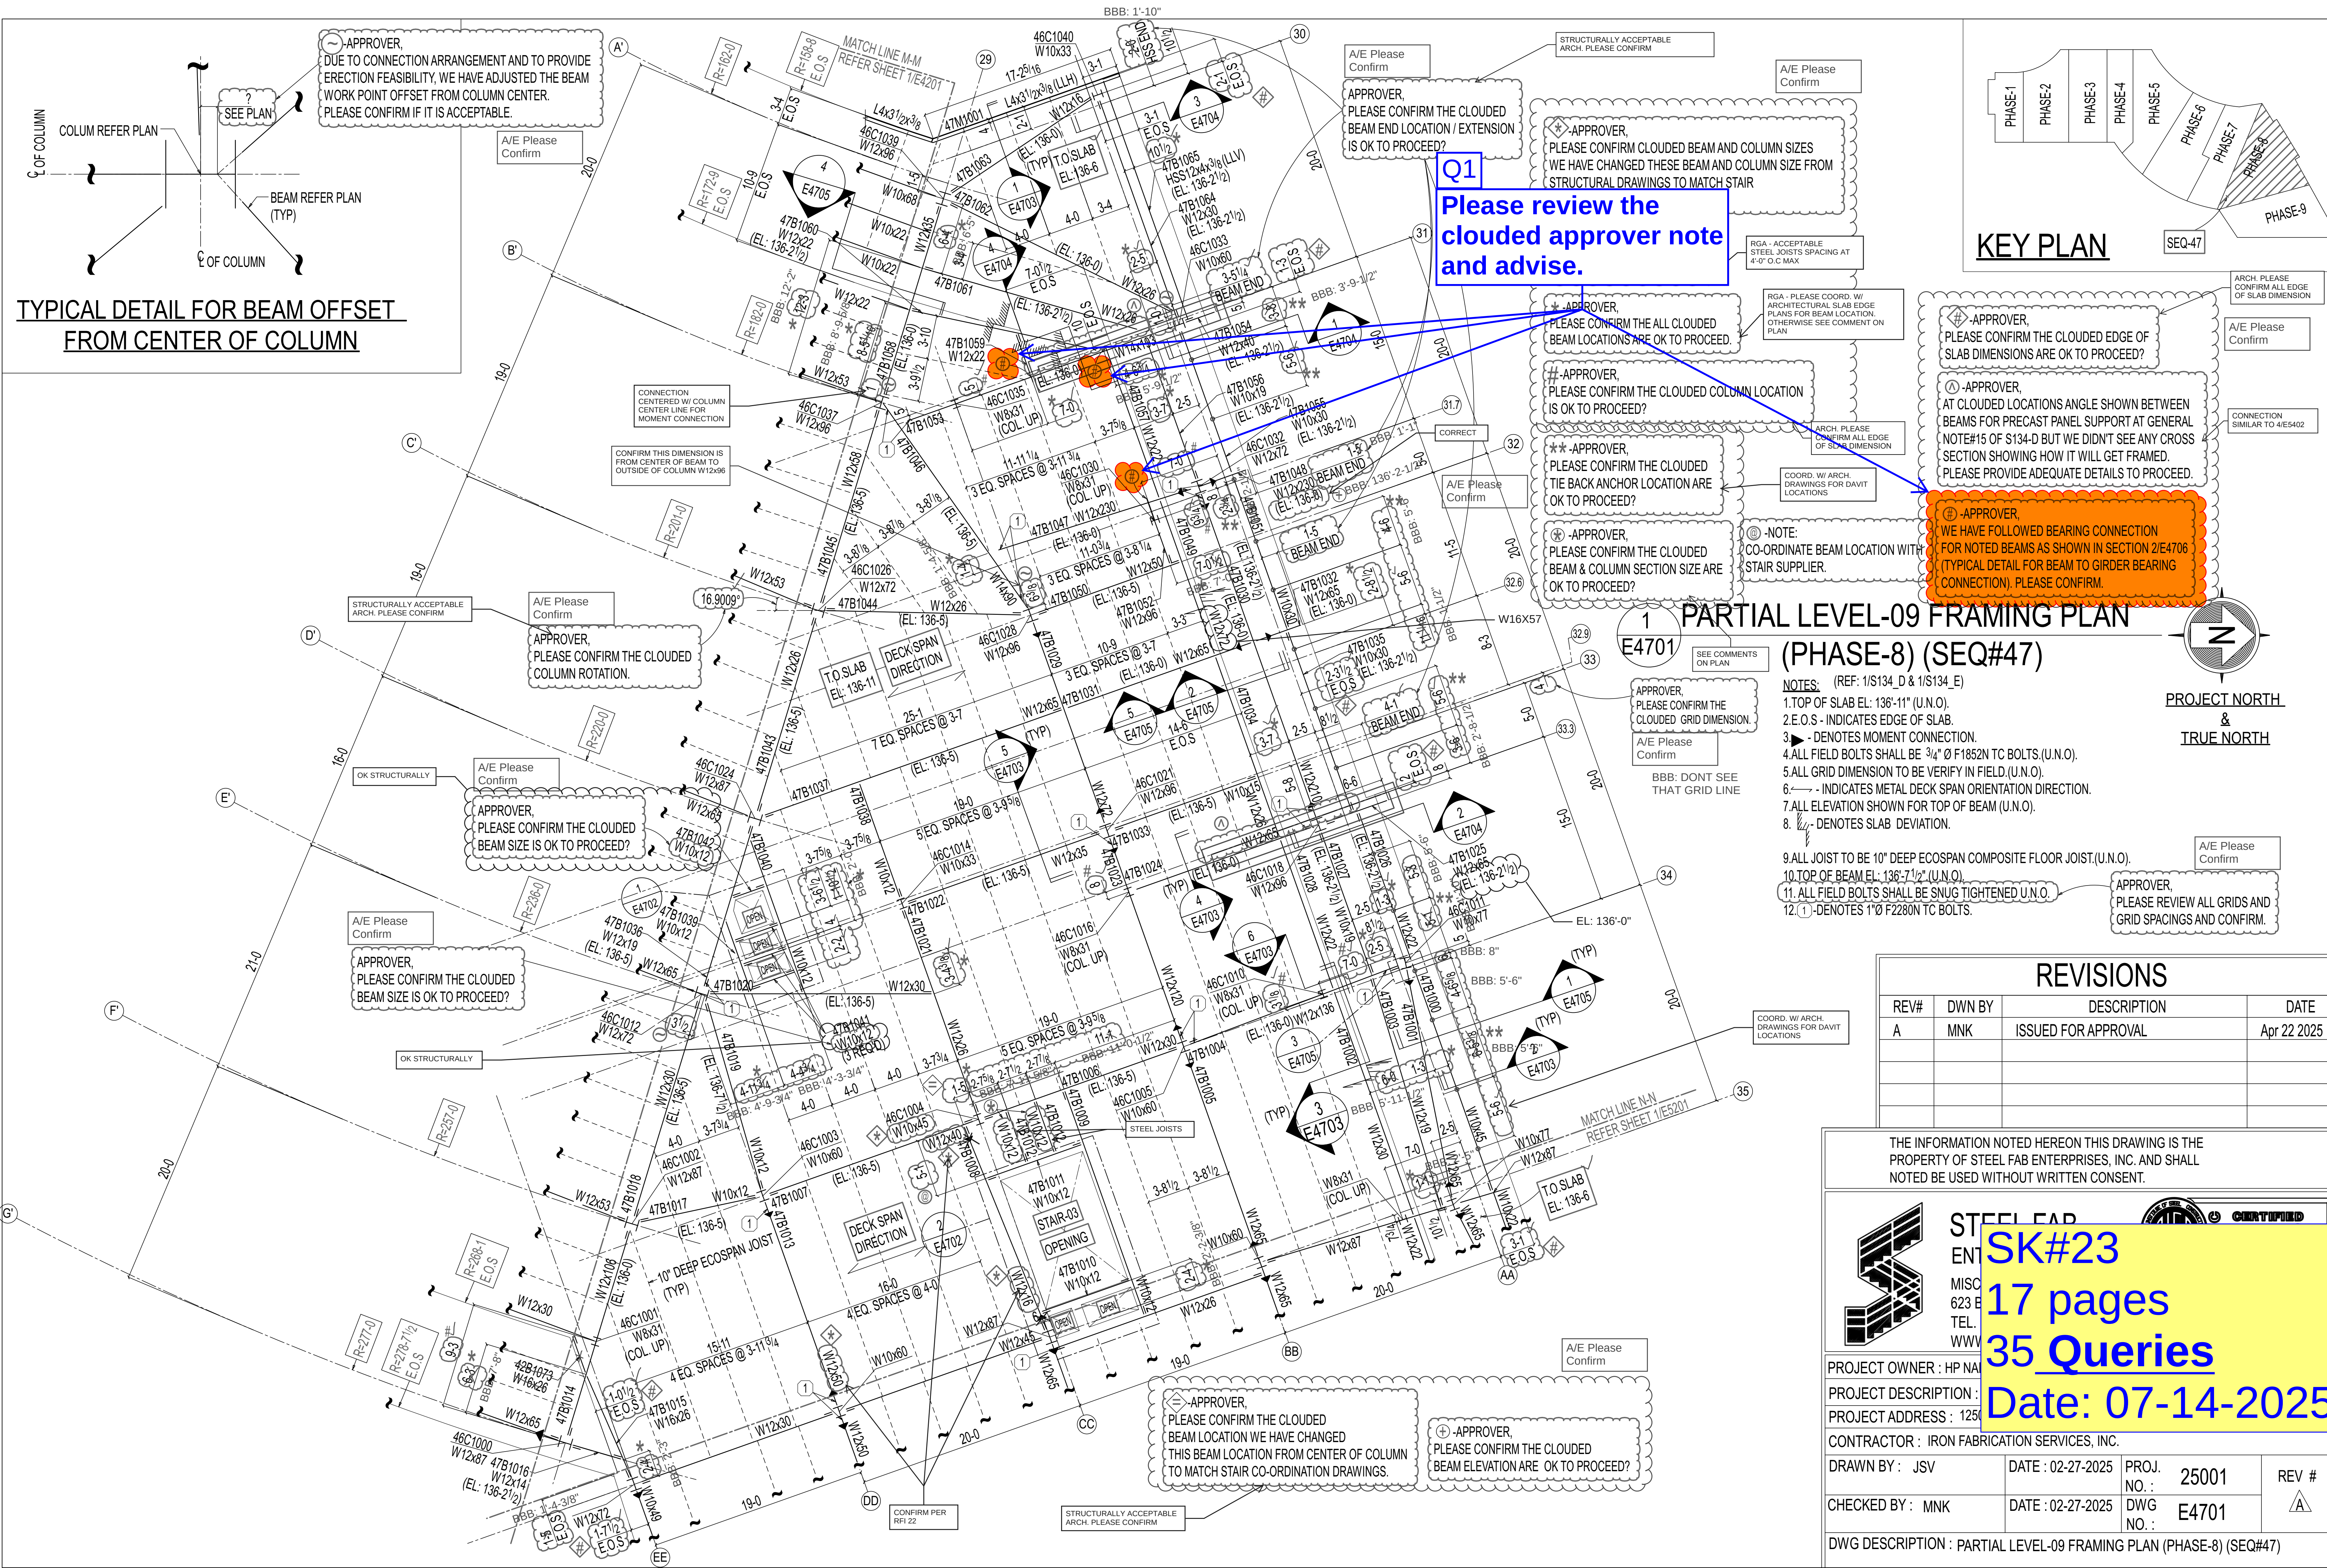


TYPICAL DETAIL FOR BEAM OFFSET FROM CENTER OF COLUMN

KEY PLAN

PARTIAL LEVEL-09 FRAMING PLAN (PHASE-8) (SEQ#47)

- NOTES: (REF: 1/S134_D & 1/S134_E)
- 1.TOP OF SLAB EL: 136'-11" (U.N.O).
 - 2.E.O.S - INDICATES EDGE OF SLAB.
 - 3 - DENOTES MOMENT CONNECTION.
 - 4.ALL FIELD BOLTS SHALL BE 3/4" Ø F1852N TC BOLTS (U.N.O).
 - 5.ALL GRID DIMENSION TO BE VERIFY IN FIELD (U.N.O).
 - 6 - INDICATES METAL DECK SPAN ORIENTATION DIRECTION.
 - 7.ALL ELEVATION SHOWN FOR TOP OF BEAM (U.N.O).
 - 8 - DENOTES SLAB DEVIATION.
 - 9.ALL JOIST TO BE 10" DEEP ECOSPAN COMPOSITE FLOOR JOIST.(U.N.O).
 - 10.TOP OF BEAM EL: 136'-7 1/2" (U.N.O).
 11. ALL FIELD BOLTS SHALL BE SNUG TIGHTENED U.N.O.
 - 12.(1)-DENOTES 1"Ø F2280N TC BOLTS.

REVISIONS			
REV#	DWN BY	DESCRIPTION	DATE
A	MNK	ISSUED FOR APPROVAL	Apr 22 2025

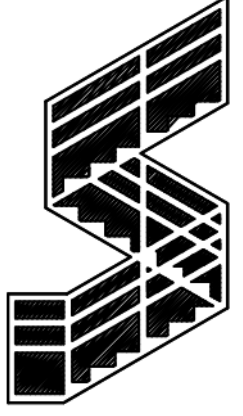

STEEL FAB
ENTERPRISES
MISC
623 E
TEL:
WWW

SK#23
17 pages
35 Queries
Date: 07-14-2025

PROJECT OWNER : HP NA
PROJECT DESCRIPTION :
PROJECT ADDRESS : 125
CONTRACTOR : IRON FABRICATION SERVICES, INC.

DRAWN BY : JSV	DATE : 02-27-2025	PROJ. NO. : 25001	REV #
CHECKED BY : MNK	DATE : 02-27-2025	DWG NO. : E4701	A

DWG DESCRIPTION : PARTIAL LEVEL-09 FRAMING PLAN (PHASE-8) (SEQ#47)


Conn. I.D	BEAM	GIRDER	GIRDER TOP ELEVATION LEVEL w.r.t. BEAM TOP ELEVATION (in.)	DESIGN LOAD		DESIGN CAPACITY (EOR TO VERIFY)	
				POSTED MAX SHEAR (kips)	GIVEN MOMENT (kips-ft)	SHEAR (kips)	MOMENT (kips-ft)
GM10-1	W10X12	W10X12	0			15	25
GM10-2	W10X12	W12X16	-2.5			15	25
GM10-3	W10X15	W18X97	7.5			15	25
GM12-1	W12X58	W12X170	2.5	30		30	120
GM12-2	W12X65	W12X210	0	70	160	70	160
GM12-3	W12X26	W12X120	-2.5	20	45	20	45

Note: due to software limitations, we are unable to model a beam-to-beam connection directly. Each connection has separate calculations for moment and shear loads. Markups are provided on the drawing – please follow them. Shear tab connection is designed separately for shear load.

continued on next page...

continued on next page..

Limit State	Required	Available	Unity Check	Result
Left Moment Plate Tearout	146.56 kips	638.59 kips	0.23	PASS
Right Moment Plate Tearout	146.56 kips	638.59 kips	0.23	PASS
Bolt Bearing at Left Beam Web	70.00 kips	95.43 kips	0.73	PASS
Bolt Bearing at Left Shear Plate	70.00 kips	88.90 kips	0.79	PASS
Bolt Bearing at Right Beam Web	70.00 kips	95.43 kips	0.73	PASS
Bolt Bearing at Right Shear Plate	70.00 kips	88.90 kips	0.79	PASS
Bolt Shear at Left Beam Web	70.00 kips	95.43 kips	0.73	PASS
Bolt Shear at Right Beam Web	70.00 kips	95.43 kips	0.73	PASS
Moment Plate Tension Yield	146.56 kips	388.80 kips	0.38	PASS
Left Moment Plate Tension Rupture	146.56 kips	443.70 kips	0.33	PASS
Right Moment Plate Tension Rupture	146.56 kips	443.70 kips	0.33	PASS
Flange Plate Compression	146.56 kips	359.94 kips	0.41	PASS

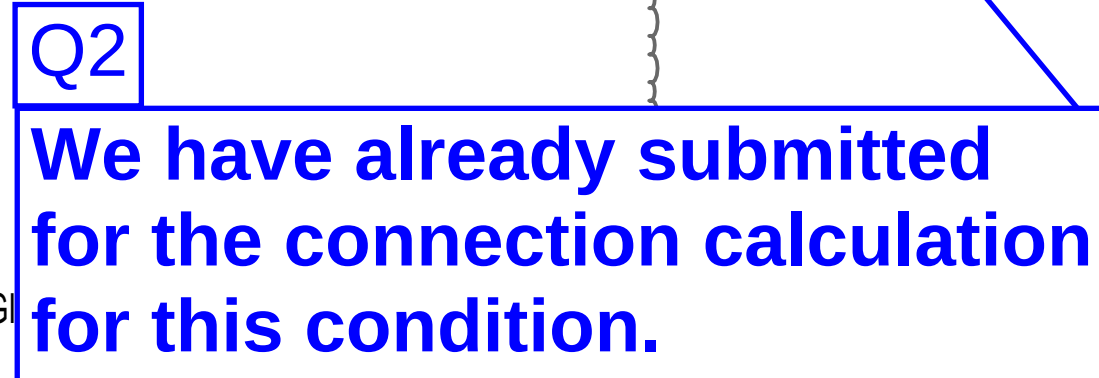

5 SECTION
E4705 OTHERS NOT SHOWN
FOR CLARITY



REV#	DWN BY	DESCRIPTION	DATE
A	MNK	ISSUED FOR APPROVAL	Apr 22 2025

THE INFORMATION NOTED HEREON THIS DRAWING IS THE
PROPERTY OF STEEL FAB ENTERPRISES, INC. AND SHALL
NOTED BE USED WITHOUT WRITTEN CONSENT.



STEEL FAB
ENTERPRISES, LLC

MISCELLANEOUS METALS FABRICATOR AND ERECTORS
623 BAUMGARDNER ROAD, LANCASTER, PA 17603
TEL. (717)464-0330 FAX (717)464-9464
WWW.STEELFABENTERPRISES.COM



PROJECT OWNER : HP NAREF, 1250 MARYLAND HOLDINGS 1 LP.

PROJECT DESCRIPTION : 1250 MARYLAND AVENUE

PROJECT ADDRESS : 1250 MARYLAND AVENUE, WASHINGTON, DC 20024

CONTRACTOR : IRON FABRICATION SERVICES, INC.

DRAWN BY : JSV

DATE : 02-27-2025

PROJ.	05004
-------	-------

REV #

NO.:	25001
------	-------

CHECKED BY: MNK

DATE : 02-27-2025

DWG E4705

	DWG DESCRIPTION : SECTIONS & DETAIL
--	-------------------------------------

Q3

Please advise if we must follow the beam elevation at 158'-5"? since the slab thick is 3 1/2" + 2 1/2" joist shoe depth = 6" minus from top of slab 159-9 will be EL.159-3.

Please review & confirm.

Q4

We have followed the blue highlighted beam locations as 6'-3" in lieu of 6'-6" since the architectural drawing 1/A058 shows the beam center 1'-0" from edge of slab. Please confirm.

Q5

We have followed the beam elevation at 159'-5 1/2" in lieu of 159'-3" since this beam directly supported to the slab. Please confirm.

L5x5x3/8 for precast panel support

Q6

We have followed the precast panel support angle location as 0'-3 1/4" from the grid 33.3. Please confirm if this is acceptable?

Also, please confirm the angle orientation.

Q7

Beam will clash with the green clouded column base plate if we follow the magenta clouded dimension for the beam location.

So, we have followed 1'-6 1/4" in lieu of 1'-3". Please confirm.

PARTIAL LEVEL-11 FRAMING PLAN (PHASE-8) (SEQ#49)

(REF: 1/S136_D & S136_E)

NOTES:

- 1.TOP OF SLAB EL: 159'-9" (U.N.O).
- 2.E.O.S - INDICATES EDGE OF SLAB.
3. - DENOTES MOMENT CONNECTION.
- 4.ALL FIELD BOLTS SHALL BE 3/4" Ø F1852N TC BOLTS (U.N.O).
- 5.ALL GRID DIMENSION TO BE VERIFY IN FIELD (U.N.O).
6. - INDICATES METAL DECK SPAN ORIENTATION DIRECTION.
- 7.ALL ELEVATION SHOWN FOR TOP OF BEAM (U.N.O).
8. - DENOTES SLAB DEVIATION.
- 9.ALL JOIST TO BE 10" DEEP ECOSPAN COMPOSITE FLOOR JOIST (U.N.O).
- 10.TOP OF STEEL EL: 159'-5 1/2" (U.N.O).
- 11.ALL FIELD BOLTS SHALL BE SNUG TIGHTENED U.N.O



REVISIONS

DESCRIPTION	DATE
FOR APPROVAL	Apr 22 2025

THE INFORMATION NOTED HEREON THIS DRAWING IS THE PROPERTY OF STEEL FAB ENTERPRISES, INC. AND SHALL NOT BE USED WITHOUT WRITTEN CONSENT.



**STEEL FAB
ENTERPRISES, LLC**

MISCELLANEOUS METALS FABRICATOR AND ERECTORS
623 BAUMGARDNER ROAD, LANCASTER, PA 17603
TEL. (717)464-0330 FAX (717)464-9464
WWW.STEELFABENTERPRISES.COM



PROJECT OWNER : HP NAREF, 1250 MARYLAND HOLDINGS 1 LP.

PROJECT DESCRIPTION : 1250 MARYLAND AVENUE

PROJECT ADDRESS : 1250 MARYLAND AVENUE, WASHINGTON, DC 20024

CONTRACTOR : IRON FABRICATION SERVICES, INC.

DRAWN BY : JSV	DATE : 02-27-2025	PROJ. NO. : 25001	REV #
CHECKED BY : MNK	DATE : 02-27-2025	DWG NO. : E4901	▲

DWG DESCRIPTION : PARTIAL LEVEL-11 FRAMING PLAN (PHASE-8) (SEQ#49)

TYPICAL DETAIL FOR BEAM OFFSET FROM CENTER OF COLUMN

Q10
Please review the green clouded note and confirm the column section size.

APPROVER, PLEASE CONFIRM THE CLOUDED COLUMN SIZE IS OK TO PROCEED?

KEY PLAN

APPROVER, PLEASE CONFIRM FOR THE CLOUDED BEAM LOCATION WE HAVE REMOVED MOMENT CONNECTIONS AS PER STAIR CO-ORDINATION DRAWING.

APPROVER, WE HAVE FOLLOWED BEARING CONNECTION FOR NOTED BEAMS AS SHOWN IN SECTION 6/E4904 (TYPICAL DETAIL FOR BEAM TO GIRDER BEARING CONNECTION), PLEASE CONFIRM.

PARTIAL LEVEL-11 FRAMING PLAN (PHASE-8) (SEQ#49)

- NOTES:
- 1.TOP OF SLAB EL: 159'-9" (U.N.O).
 - 2.E.O.S - INDICATES EDGE OF SLAB.
 3. - DENOTES MOMENT CONNECTION.
 - 4.ALL FIELD BOLTS SHALL BE 3/4" Ø F1852N TC BOLTS (U.N.O).
 - 5.ALL GRID DIMENSION TO BE VERIFY IN FIELD (U.N.O).
 6. - INDICATES METAL DECK SPAN ORIENTATION DIRECTION.
 - 7.ALL ELEVATION SHOWN FOR TOP OF BEAM (U.N.O).
 8. - DENOTES SLAB DEVIATION.
 - 9.ALL JOIST TO BE 10" DEEP ECOSPAN COMPOSITE FLOOR JOIST (U.N.O).
 - 10.TOP OF STEEL EL: 159'-5 1/2" (U.N.O).
 11. ALL FIELD BOLTS SHALL BE SNUG TIGHTENED U.N.O

Q11
Please review the yellow clouded note and advise.

APPROVER, PLEASE CONFIRM CLOUDED BEAM ELEVATION STRUCTURAL DRAWING S136-E SHOWS EL:158-5 FOR THIS BEAM. BUT WE BELIVE THIS BEAM TOP SHOULD MATCH TOP OF ADJACENT JOIST EL:158-7 1/2. PLEASE CONFIRM.

****APPROVER, DUE TO CONNECTION ARRANGEMENT AND TO PROVIDE ERECTION FEASIBILITY, WE HAVE ADJUSTED THE BEAM WORK POINT OFFSET FROM COLUMN CENTER. PLEASE CONFIRM IF IT IS ACCEPTABLE. (TYP AT SIMILAR CONDITIONS)**





TYPICAL DETAIL FOR BEAM OFFSET FROM CENTER OF COLUMN

THE INFORMATION NOTED HEREON THIS DRAWING IS THE PROPERTY OF STEEL FAB ENTERPRISES, INC. AND SHALL NOTED BE USED WITHOUT WRITTEN CONSENT.

STEEL FAB ENTERPRISES, LLC
MISCELLANEOUS METALS FABRICATOR AND ERECTORS
623 BAUMGARDNER ROAD, LANCASTER, PA 17603
TEL. (717)464-0330 FAX (717)464-9464
WWW.STEELFABENTERPRISES.COM

PROJECT OWNER : HP NAREF, 1250 MARYLAND HOLDINGS 1 LP.
PROJECT DESCRIPTION : 1250 MARYLAND AVENUE
PROJECT ADDRESS : 1250 MARYLAND AVENUE, WASHINGTON, DC 20024
CONTRACTOR : IRON FABRICATION SERVICES, INC.

DRAWN BY: JSV	DATE: 02-27-2025	PROJ. NO.: 25001	REV #
CHECKED BY: MNK	DATE: 02-27-2025	DWG NO.: E4901	▲
DWG DESCRIPTION : PARTIAL LEVEL-11 FRAMING PLAN (PHASE-8) (SEQ#49)			

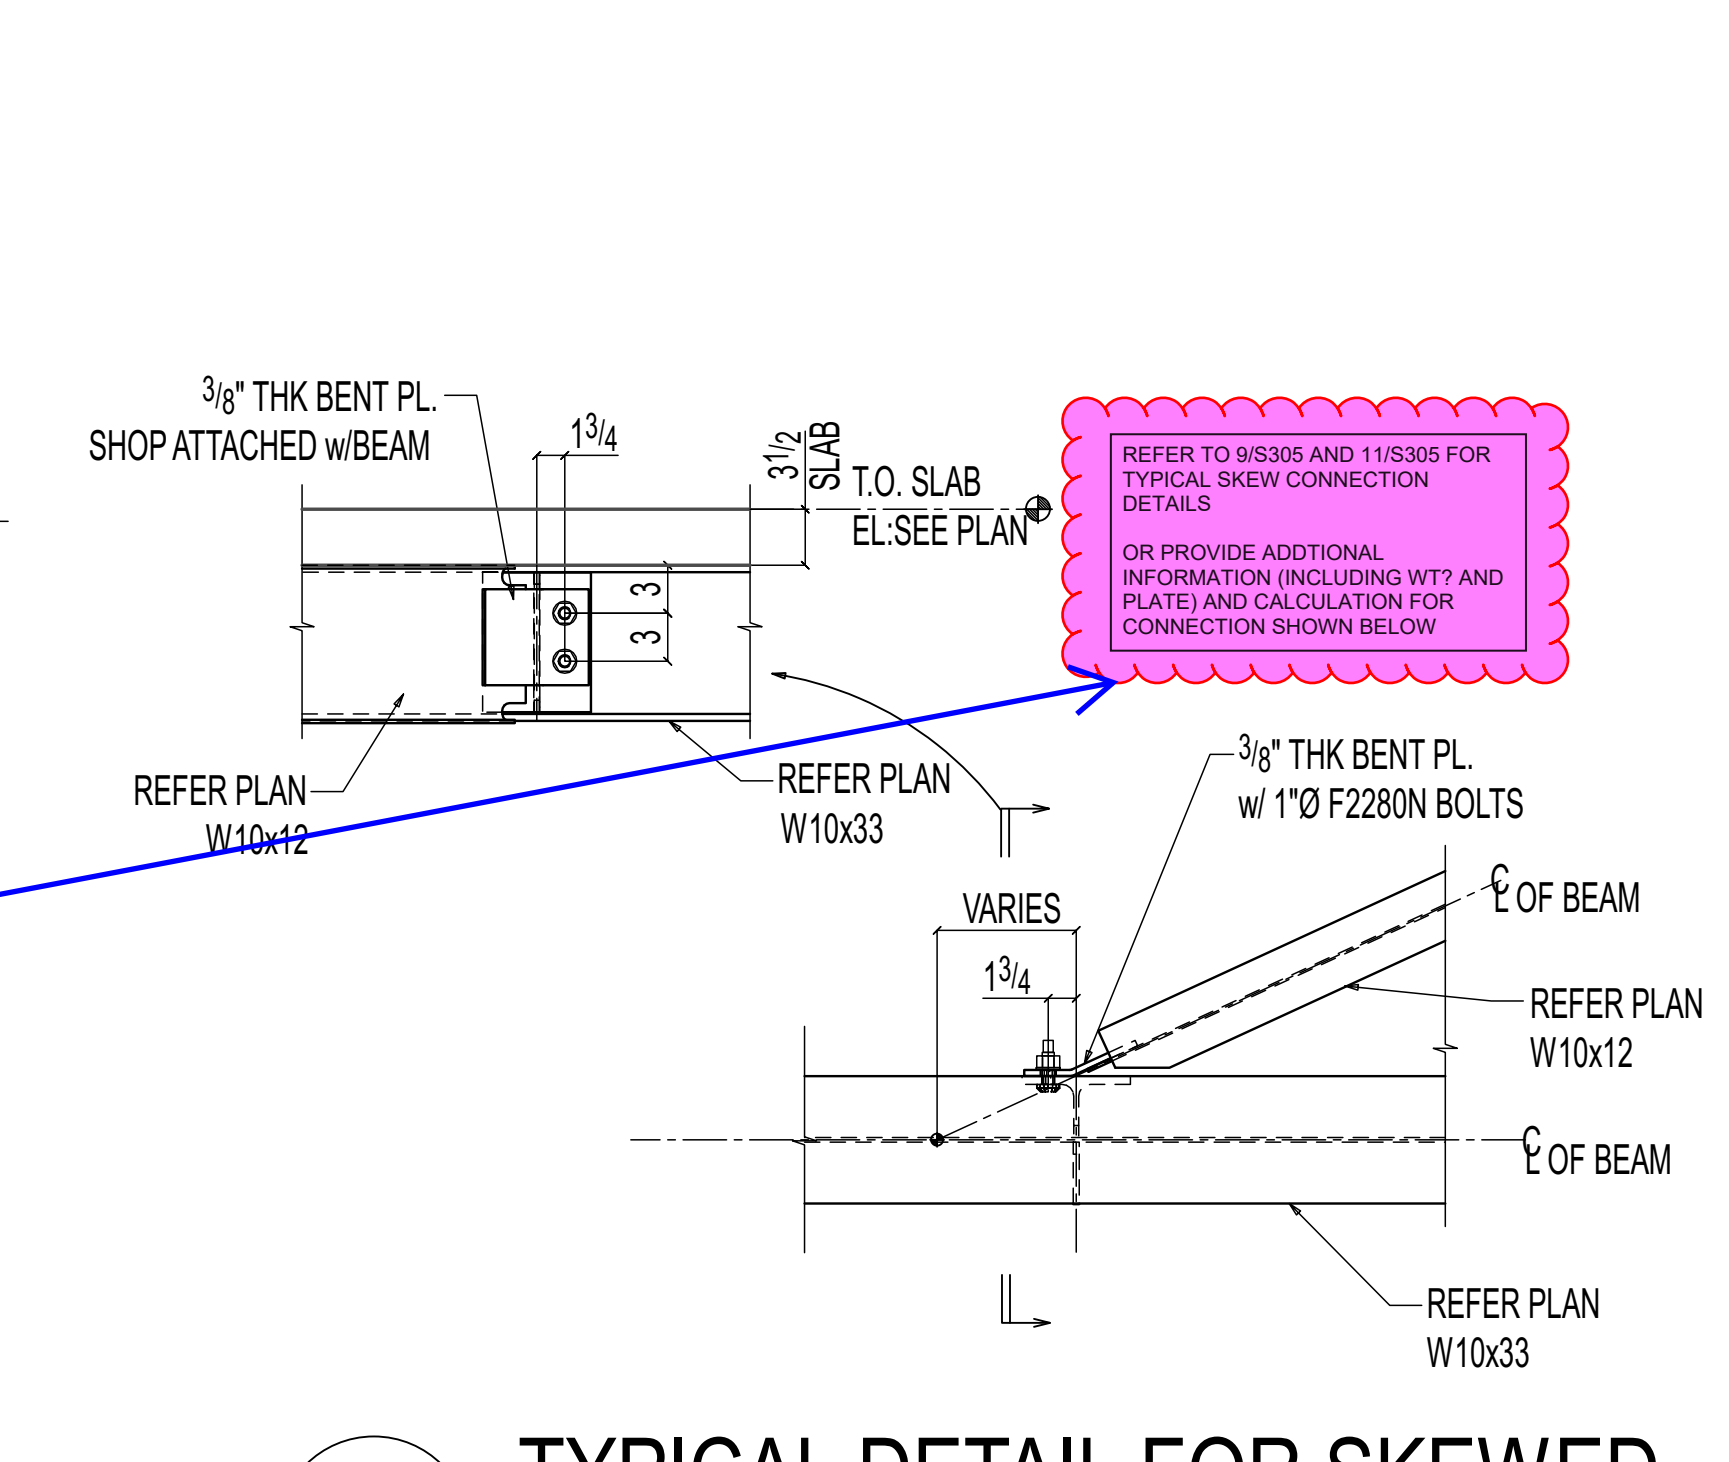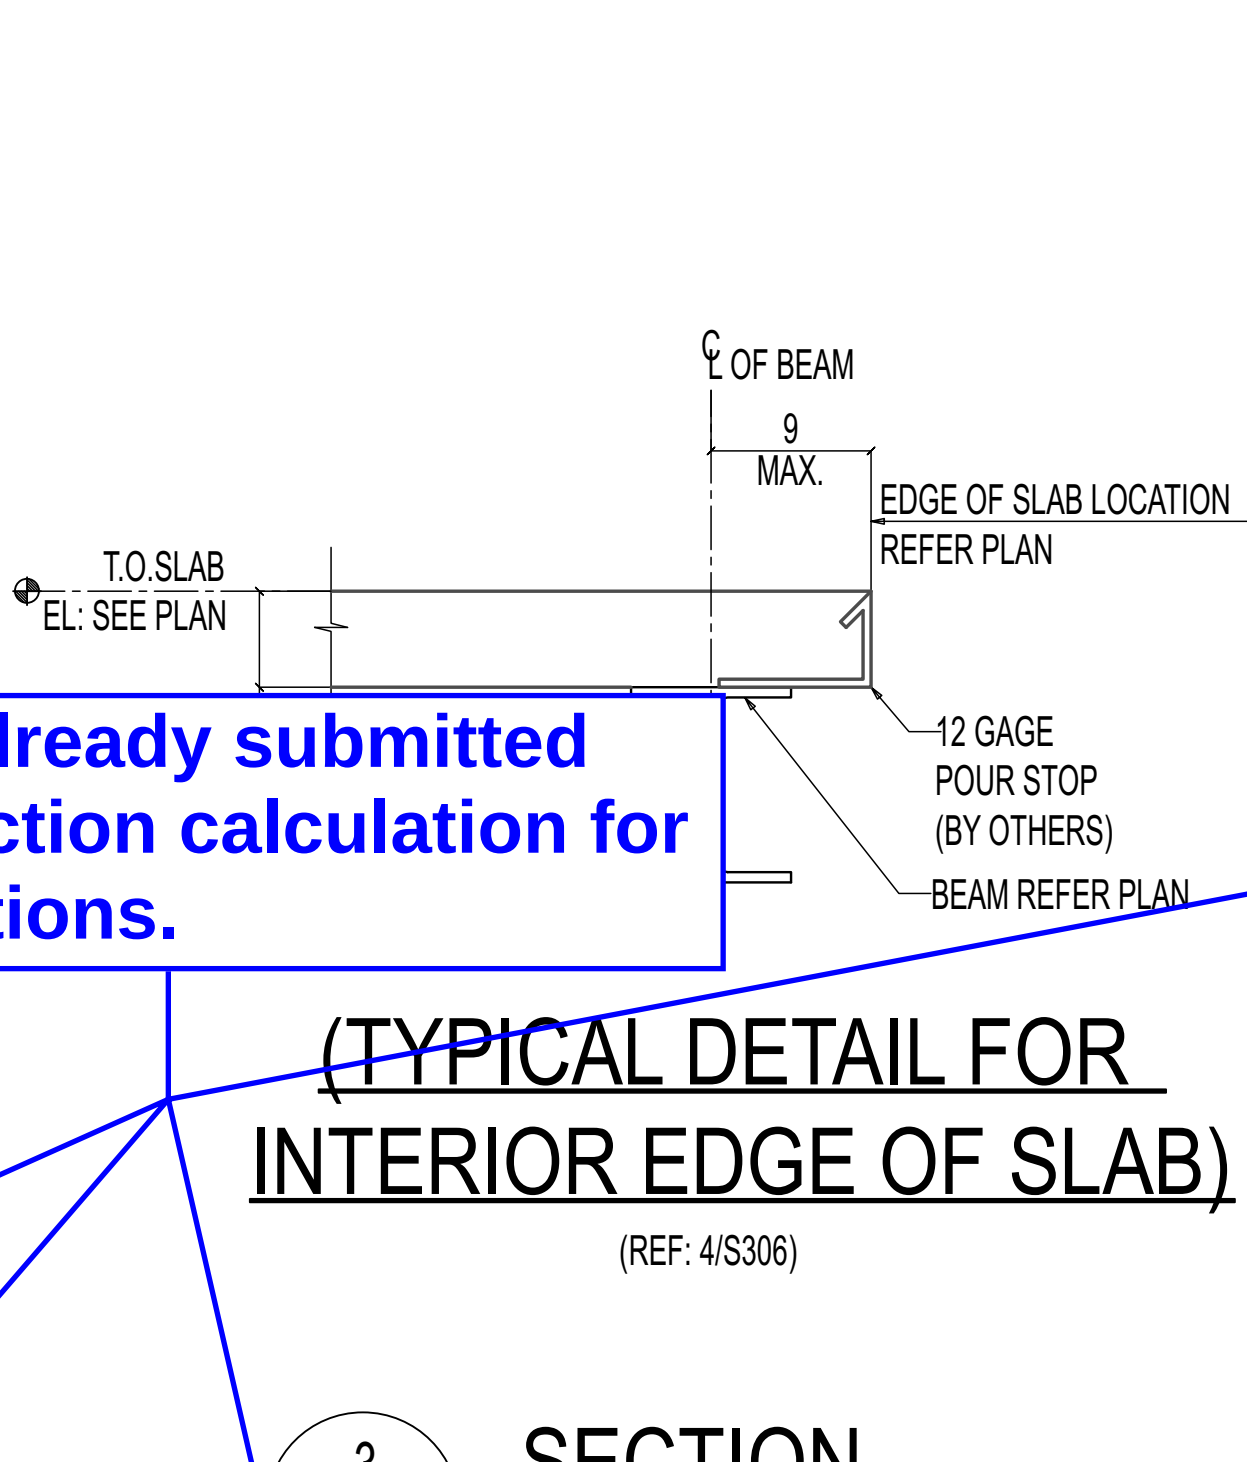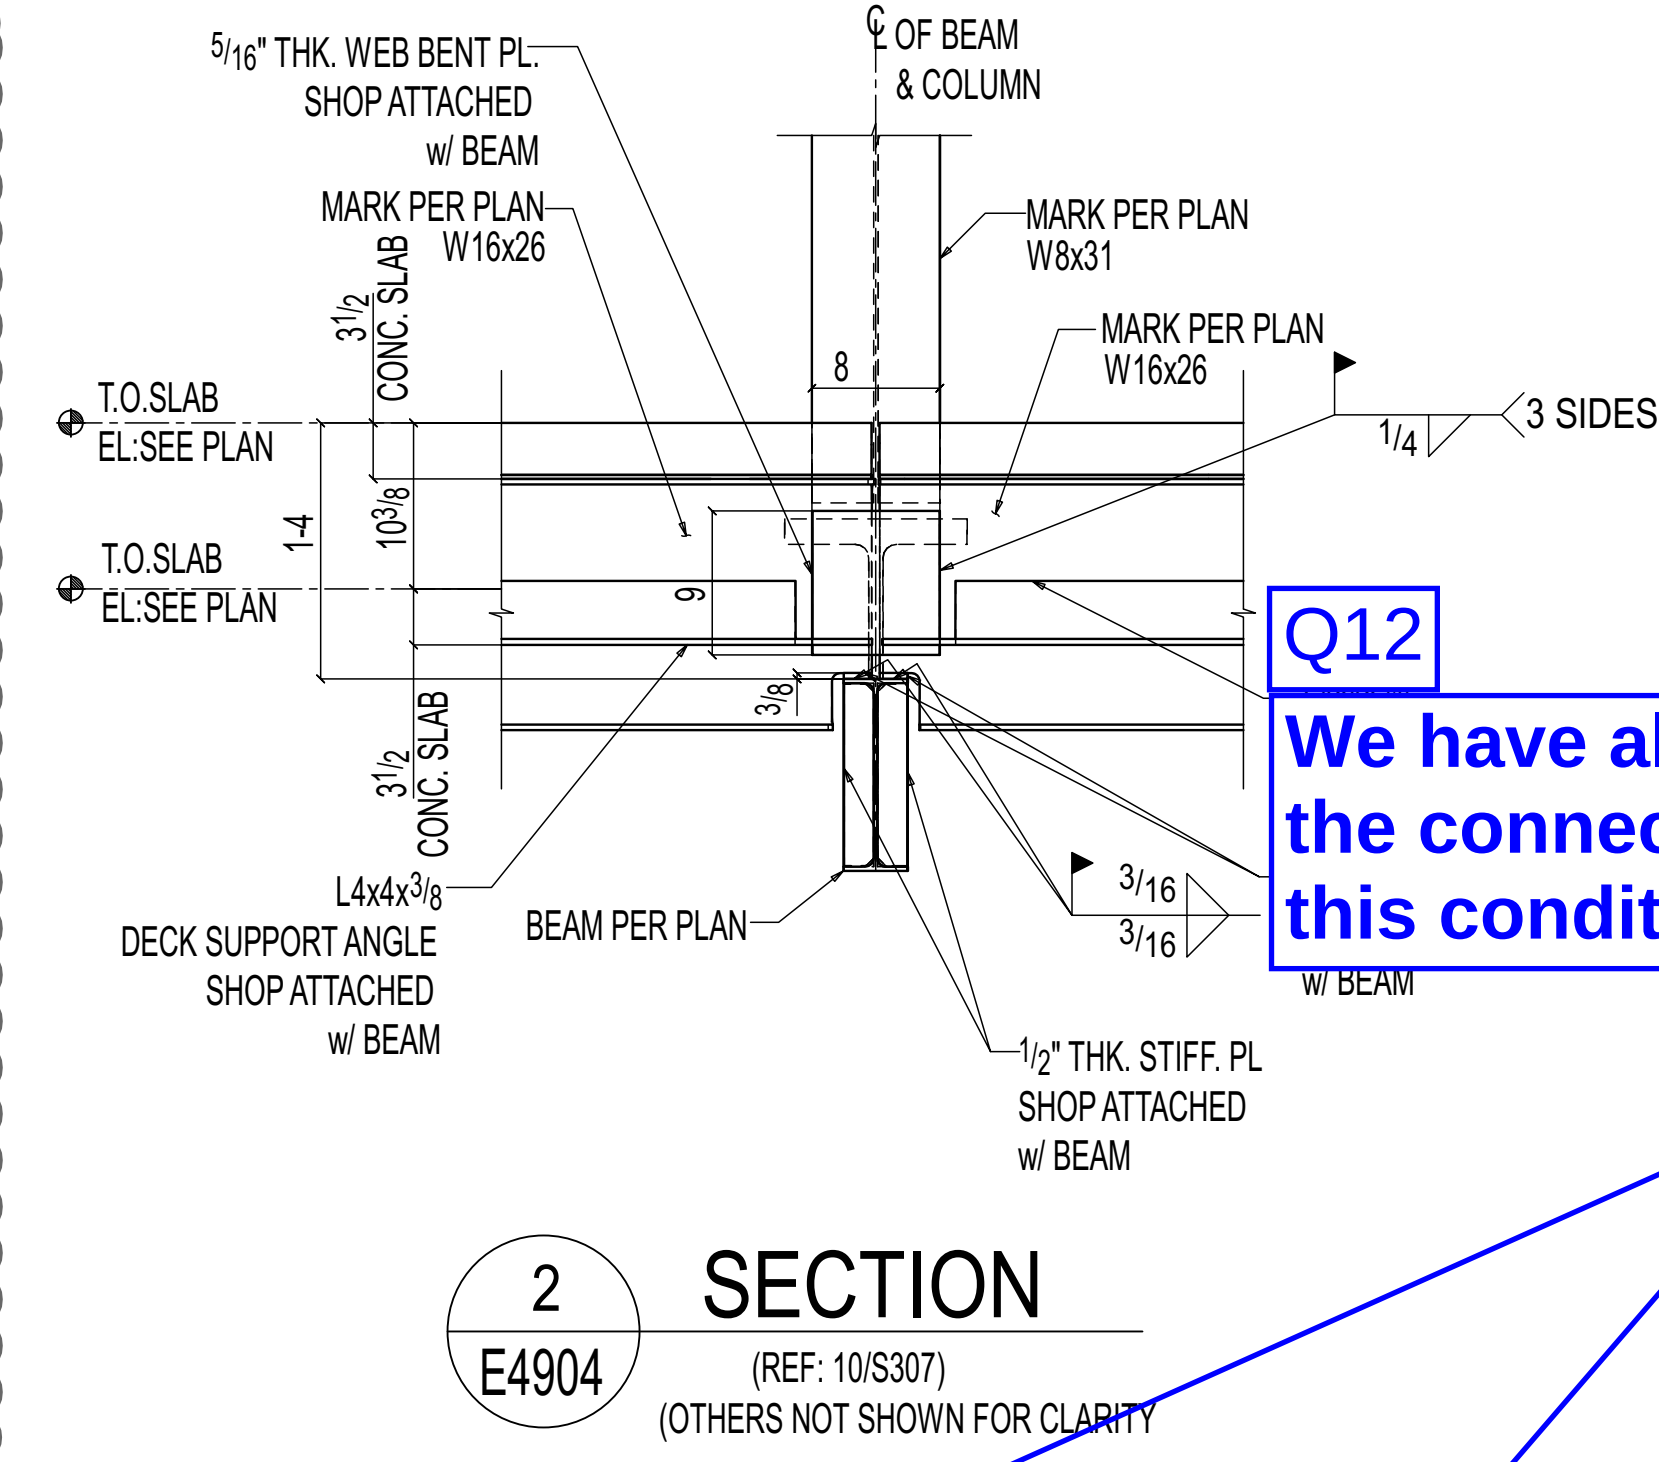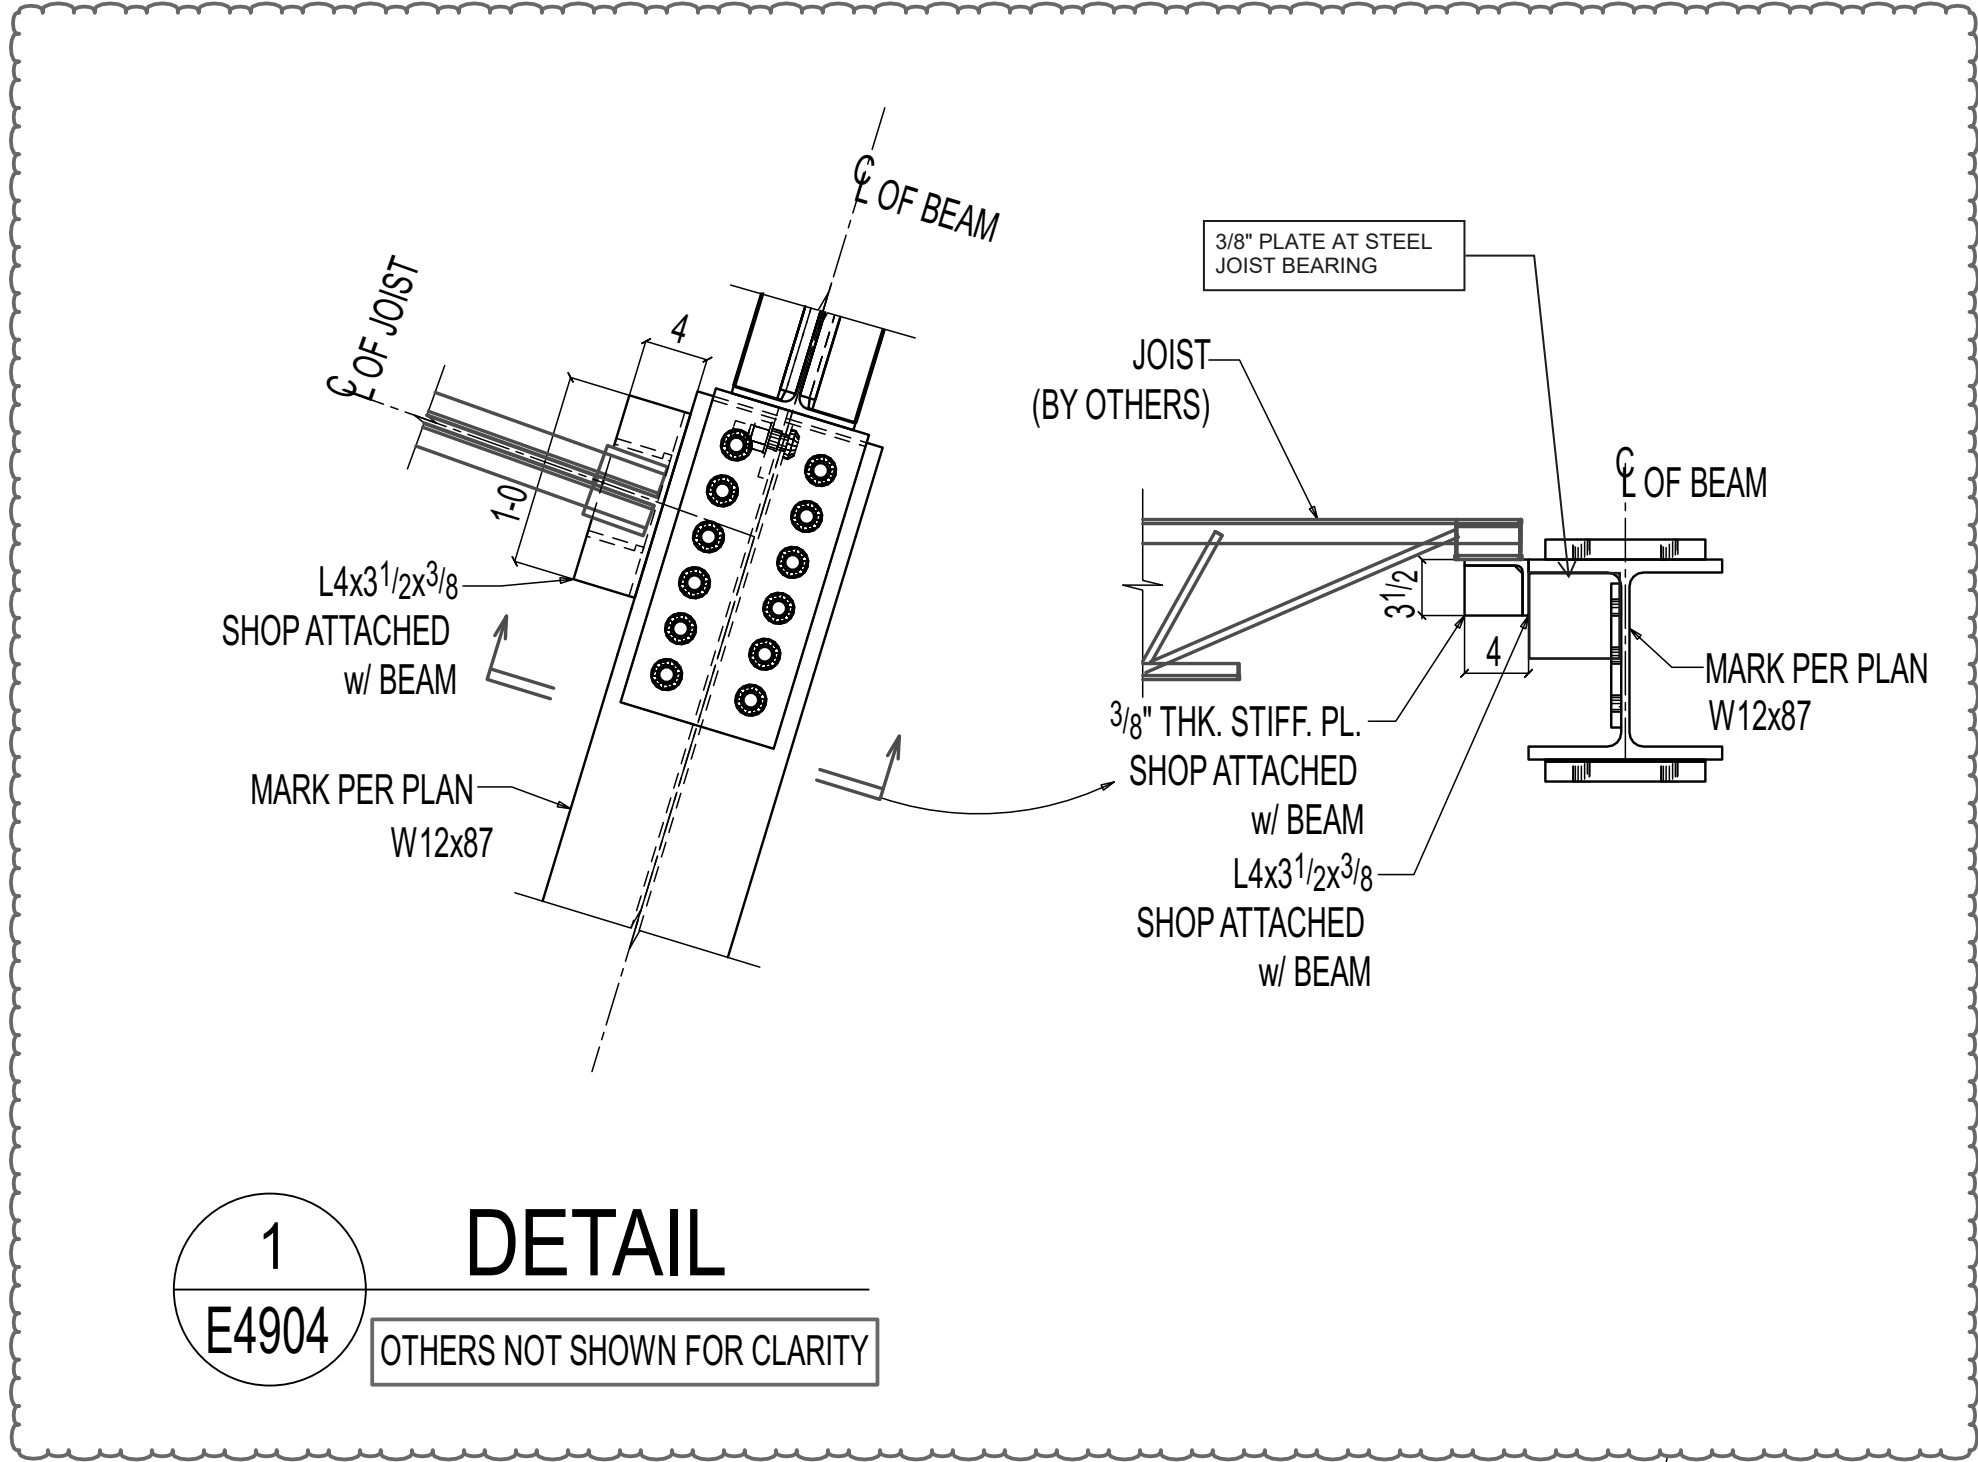


Q12
We have already submitted the connection calculation for this conditions.

(TYPICAL DETAIL FOR INTERIOR EDGE OF SLAB)
(REF: 4/S306)

APPROVER,
DUE TO THE MOMENT CONNECTION,
WE ARE UNABLE TO SEAT THE JOIST INTO THE BEAM.
THEREFORE, WE HAVE PROVIDED A SEATED ANGLE CONNECTION AS SHOWN.
PLEASE CONFIRM THE SHOWN ARRANGEMENT ARE OK TO PROCEED?
A/E Please Confirm

For Connection IDs E-5, E-7, E-32, and E-56:
This is a Bent Plate Connection that cannot be modeled due to software limitations. The connection is designed for a maximum load of 15 Kips. The Bent Plate, 3/8" thick, includes two 3/4" Dia A325-N Bolts with a minimum bolt spacing of 2.5" and a minimum edge distance of 1 1/4" all around at the Beam Side. A single 1/4" Fillet Weld with a minimum length of 6" is provided at the Girder Side. This configuration is expected to achieve the required 15 Kips capacity and will be verified.
If the skew angle is excessive, a WT Section may be welded to the Girder to facilitate the Bent Plate Connection to the WT Section instead of directly to the Girder.

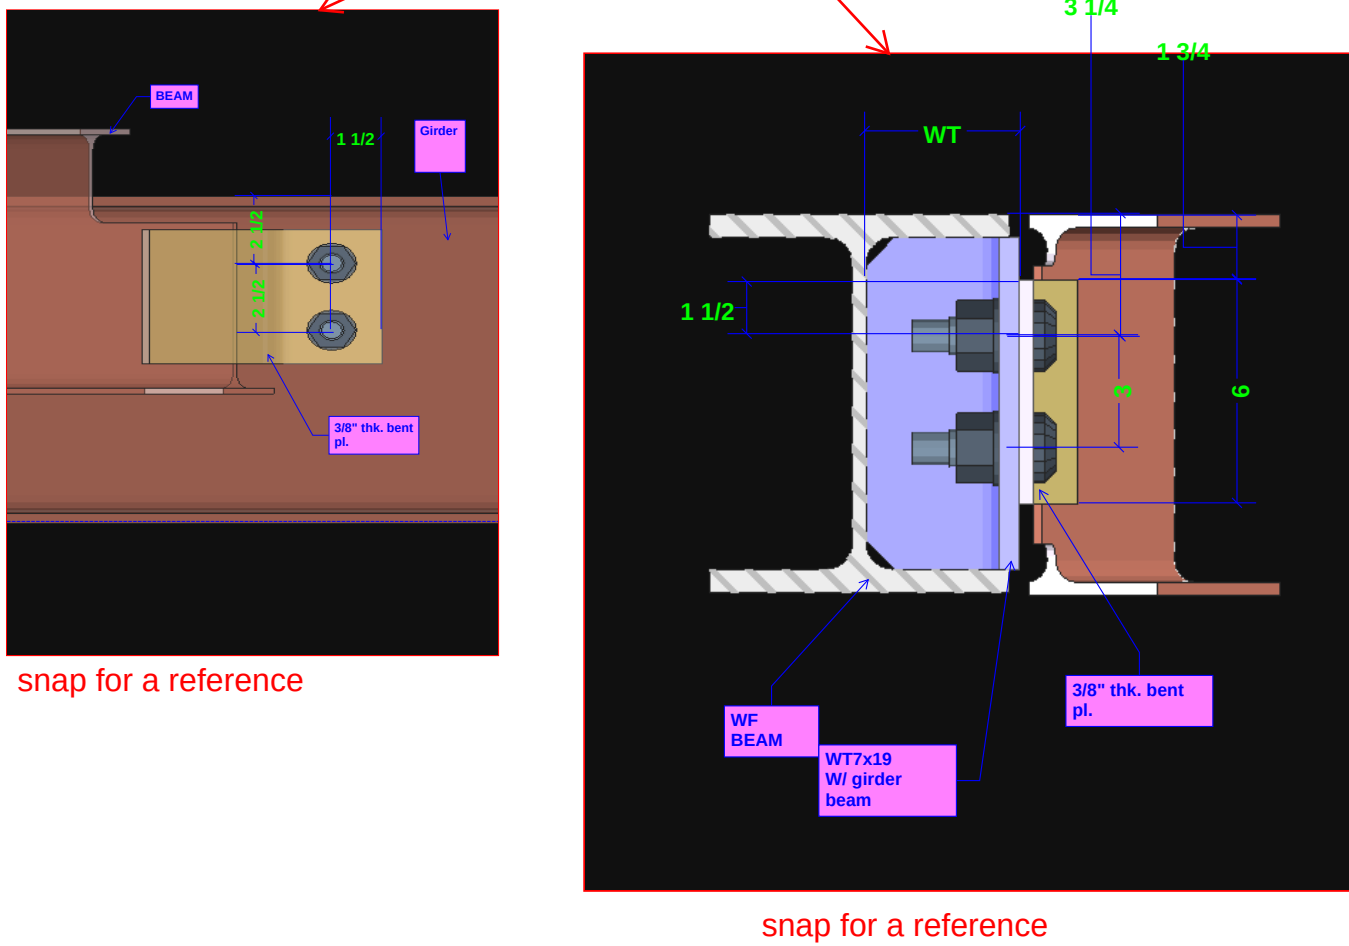

E-5: 3D View Report

REPRESENTATIVE CALCS FOR CONNECTION ID'S E-5, E-7, E-32, and E-56

E-5: LRFD Results Report

Limit State	Required	Available	Unity Check	Result
Geometry Restrictions at Girder				PASS
Beam Weld Limitations				PASS
Erection Stability				PASS
Beam Shear Yield	15.00 kips	47.59 kips	0.32	PASS
Clip Angle Shear Yield	15.00 kips	40.50 kips	0.37	PASS
Beam Shear Rupture	15.00 kips	46.41 kips	0.32	PASS
Clip Angle Shear Rupture at Beam	15.00 kips	48.94 kips	0.31	PASS
Clip Angle Shear Rupture at Girder	15.00 kips	31.81 kips	0.47	PASS
Clip Angle Block Shear at Girder	15.00 kips	40.11 kips	0.37	PASS
Coped Beam Flexural Rupture	15.00 kips	45.13 kips	0.33	PASS
Coped Beam Lateral Torsional Buckling	15.00 kips	41.66 kips	0.36	PASS
Clip Angle Flexural Yield			0.42	PASS
Clip Angle Flexural Rupture			0.25	PASS
Bolt Bearing on Girder	15.00 kips	33.34 kips	0.45	PASS
Bolt Bearing on Clip Angle at Girder	15.00 kips	34.41 kips	0.44	PASS
Bolt Shear at Girder	15.00 kips	17.99 kips	0.83	PASS
Bolt Group Eccentricity at Girder		0.50		
Bolt Prying				N/A
Bolt Tension at Girder	0.00 kips	5.35 kips	0.00	PASS
Beam Weld Strength	15.00 kips	46.09 kips	0.33	PASS

For Connection IDs E-5, E-7, E-32, and E-56:
This is a Bent Plate Connection that cannot be modeled due to software limitations. The connection is designed for a maximum load of 15 Kips. The Bent Plate, 3/8" thick, includes two 3/4" Dia A325-N Bolts with a minimum bolt spacing of 2.5" and a minimum edge distance of 1 1/4" all around at the Beam Side. A single 1/4" Fillet Weld with a minimum length of 6" is provided at the Girder Side. This configuration is expected to achieve the required 15 Kips capacity and will be verified.
If the skew angle is excessive, a WT Section may be welded to the Girder to facilitate the Bent Plate Connection to the WT Section instead of directly to the Girder.

REVISIONS			
REV#	DWN BY	DESCRIPTION	DATE
A	MNK	ISSUED FOR APPROVAL	Apr 22 2025

THE INFORMATION NOTED HEREON THIS DRAWING IS THE PROPERTY OF STEEL FAB ENTERPRISES, INC. AND SHALL NOTED BE USED WITHOUT WRITTEN CONSENT.



STEEL FAB ENTERPRISES, LLC

MISCELLANEOUS METALS FABRICATOR AND ERECTORS

623 BAUMGARDNER ROAD, LANCASTER, PA 17603

TEL. (717)464-0330 FAX (717)464-9464

WWW.STEELFABENTERPRISES.COM



PROJECT OWNER : HP NAREF, 1250 MARYLAND HOLDINGS 1 LP.

PROJECT DESCRIPTION : 1250 MARYLAND AVENUE

PROJECT ADDRESS : 1250 MARYLAND AVENUE, WASHINGTON, DC 20024




CONTRACTOR : IRON FABRICATION SERVICES, INC.

DRAWN BY : JSV	DATE : 02-27-2025	PROJ. NO. : 25001	REV #
CHECKED BY : MNK	DATE : 02-27-2025	DWG NO. : E4904	△

DWG DESCRIPTION : TYPICAL DETAILS & SECTIONS

R PLAN
FENER PLATE
HED w/ GIRDER

BEAM
INJECTION

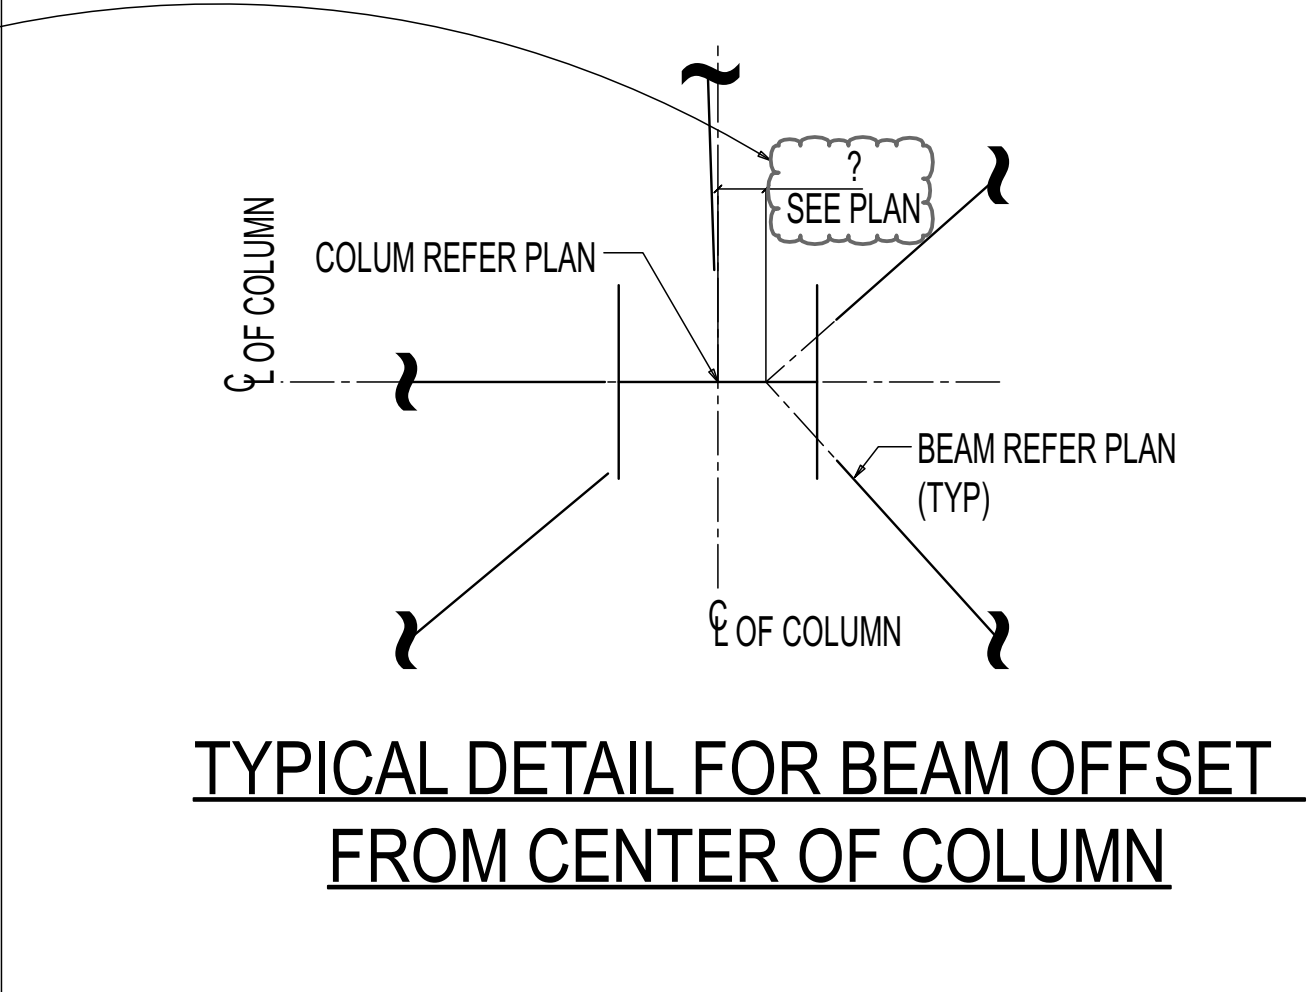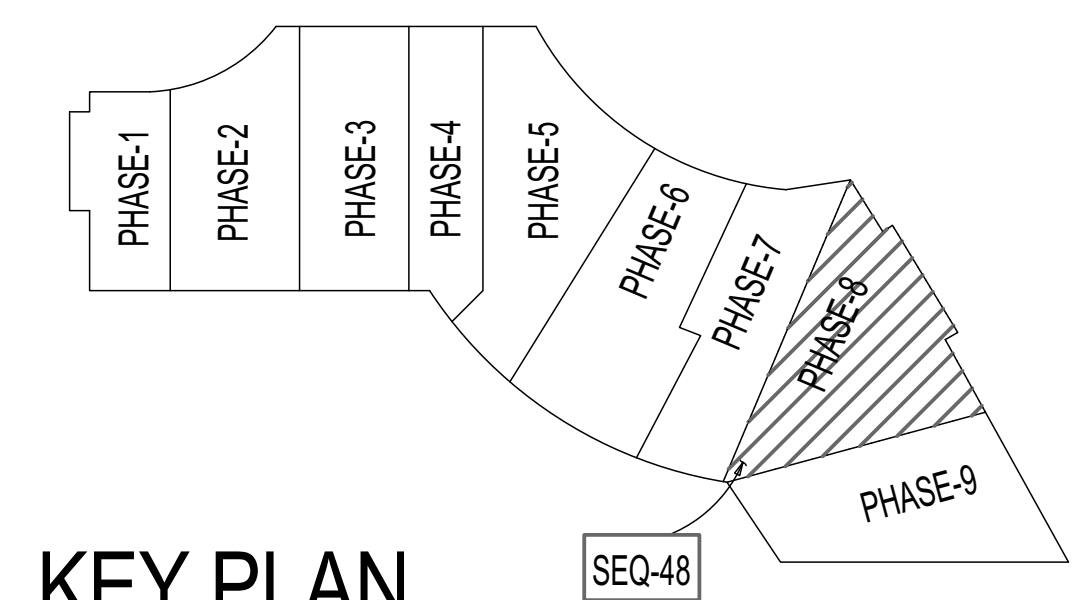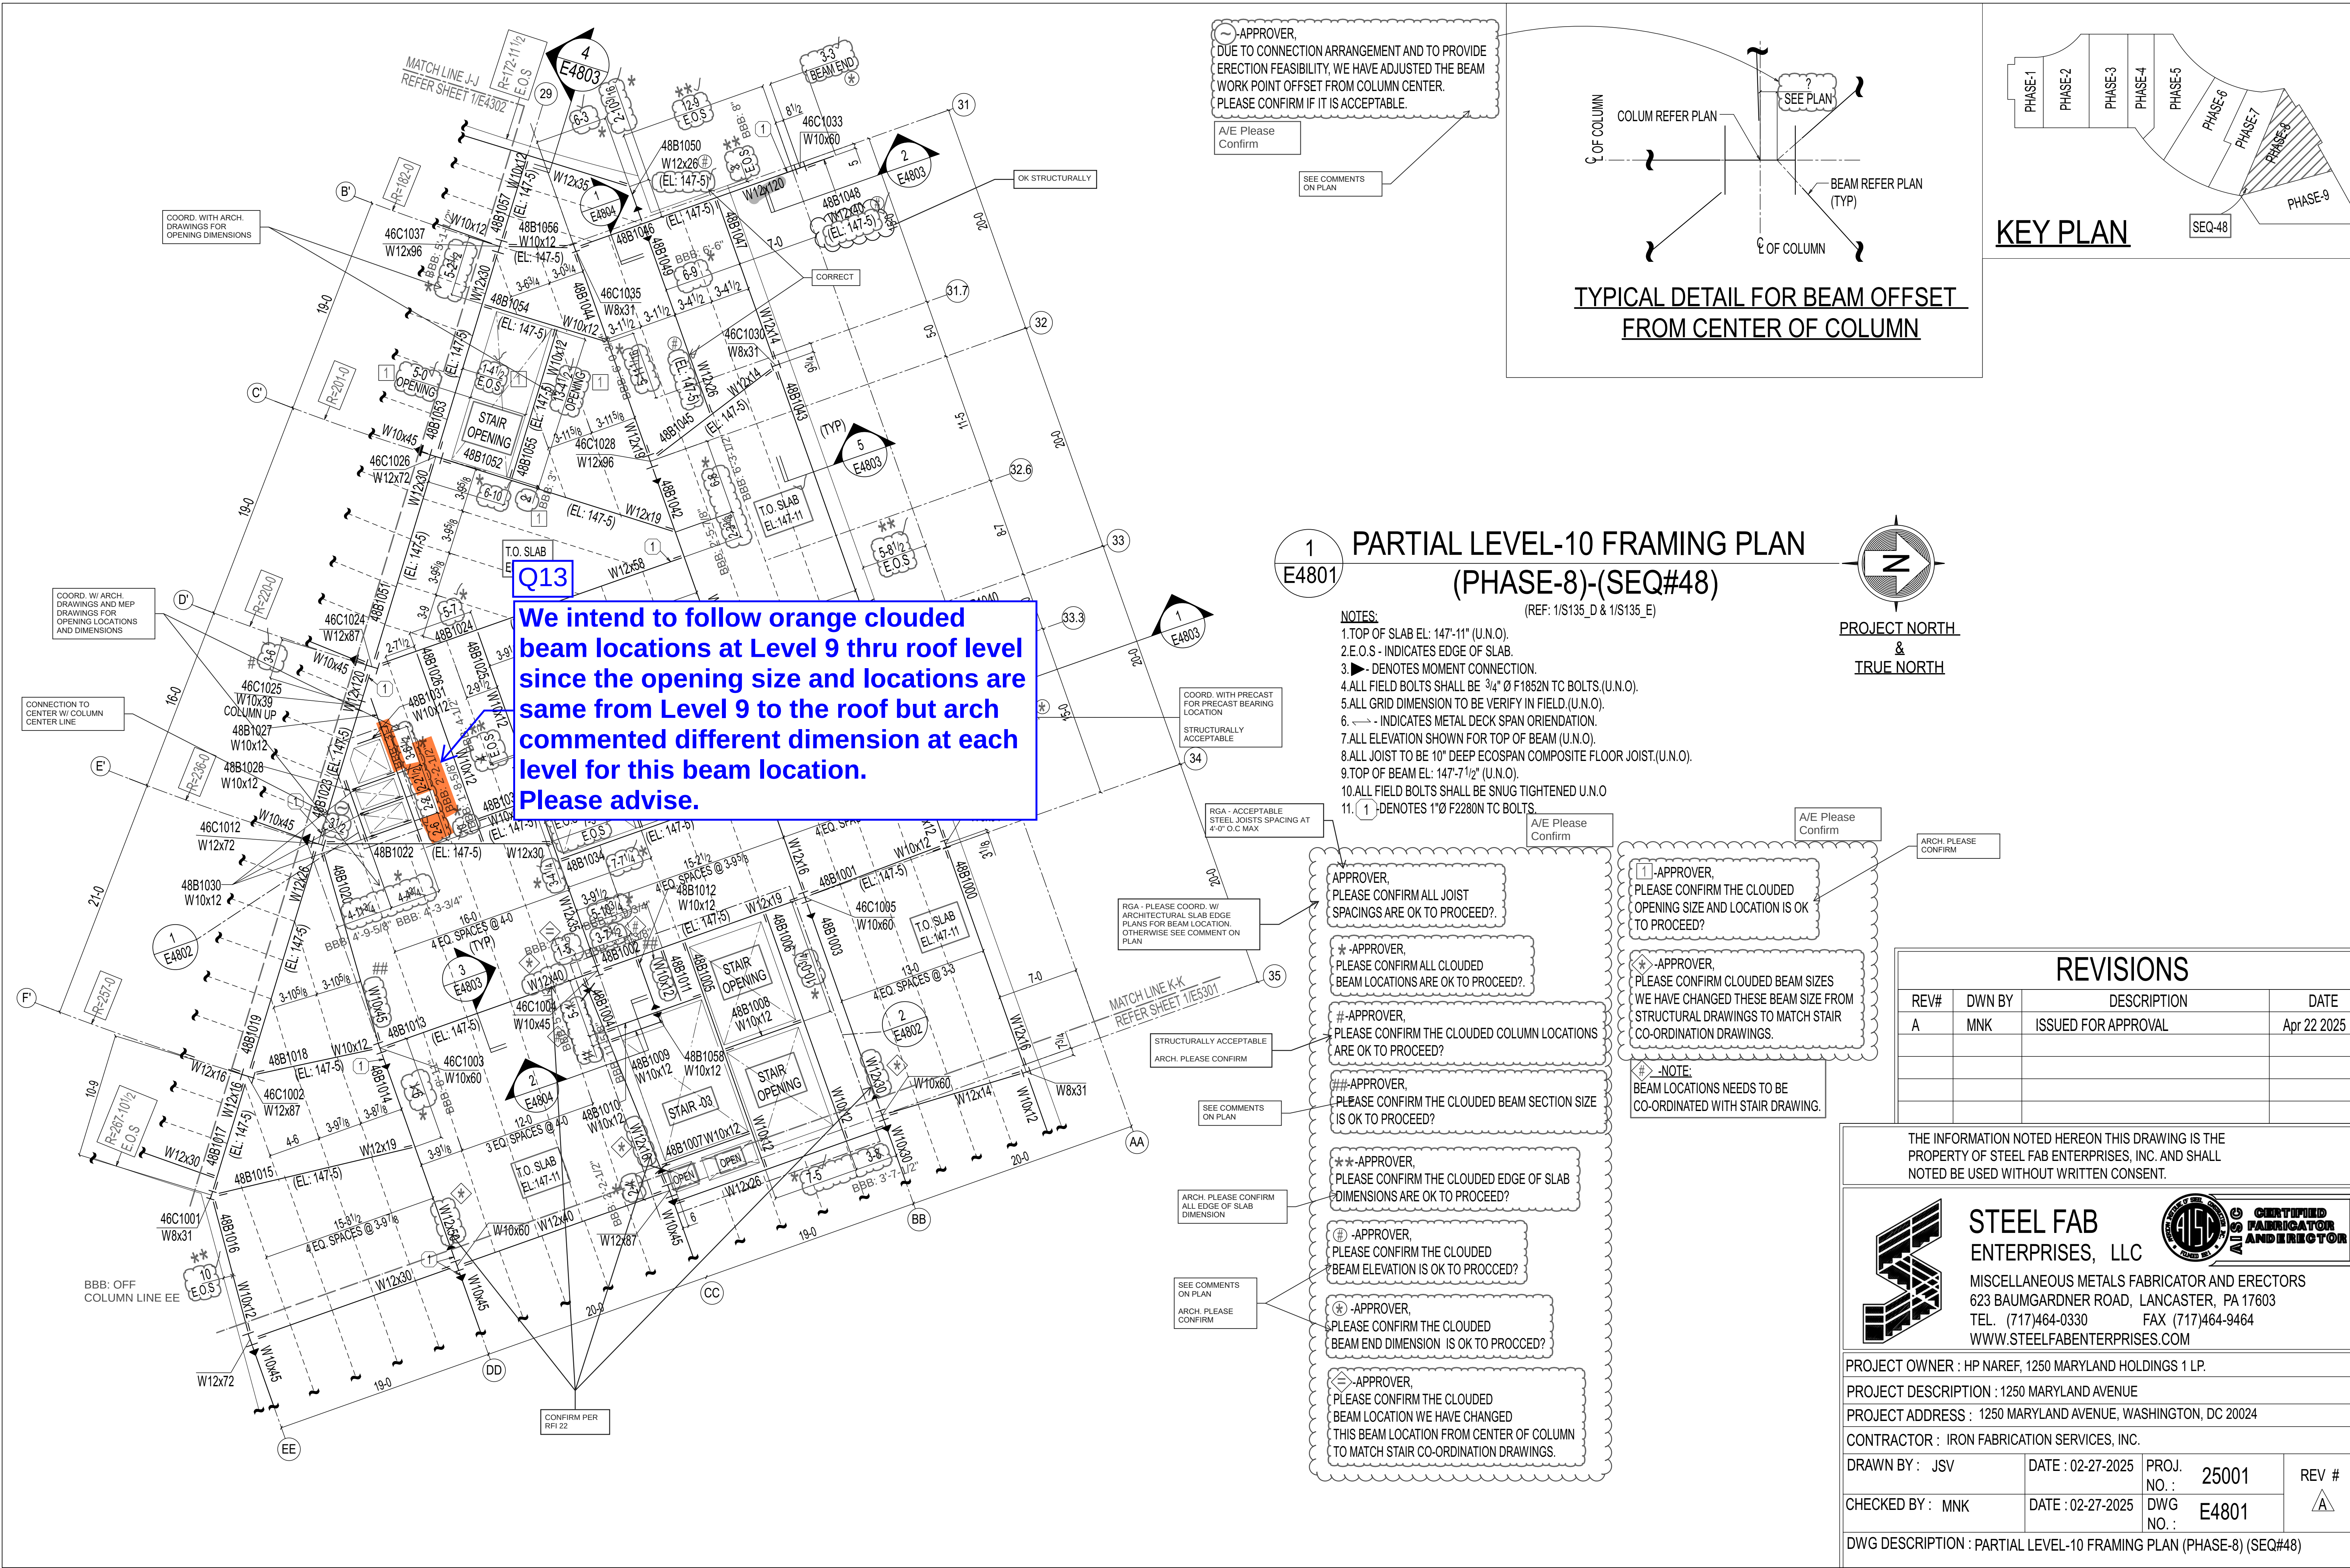

PARTIAL LEVEL-10 FRAMING PLAN (PHASE-8)-(SEQ#48)




- NOTES:
- 1.TOP OF SLAB EL: 147'-11" (U.N.O.)
 - 2.E.O.S - INDICATES EDGE OF SLAB.
 - 3.► DENOTES MOMENT CONNECTION.
 - 4.ALL FIELD BOLTS SHALL BE 3/4" Ø F1852N TC BOLTS.(U.N.O.)
 - 5.ALL GRID DIMENSION TO BE VERIFY IN FIELD.(U.N.O.)
 - 6.↔ - INDICATES METAL DECK SPAN ORIENTATION.
 - 7.ALL ELEVATION SHOWN FOR TOP OF BEAM (U.N.O.)
 - 8.ALL JOIST TO BE 10" DEEP ECOSPAN COMPOSITE FLOOR JOIST.(U.N.O.)
 - 9.TOP OF BEAM EL: 147'-7 1/2" (U.N.O.)
 - 10.ALL FIELD BOLTS SHALL BE SNUG TIGHTENED U.N.O
 11. (1) DENOTES 1"Ø F2280N TC BOLTS

REVISIONS

REV#	DWN BY	DESCRIPTION	DATE
A	MNK	ISSUED FOR APPROVAL	Apr 22 2025


THE INFORMATION NOTED HEREON THIS DRAWING IS THE PROPERTY OF STEEL FAB ENTERPRISES, INC. AND SHALL NOTED BE USED WITHOUT WRITTEN CONSENT.

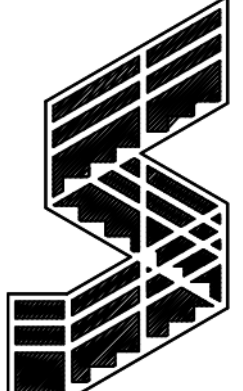

STEEL FAB ENTERPRISES, LLC
MISCELLANEOUS METALS FABRICATOR AND ERECTORS
623 BAUMGARDNER ROAD, LANCASTER, PA 17603
TEL. (717)464-0330 FAX (717)464-9464
WWW.STEELFABENTERPRISES.COM

**CERTIFIED FABRICATOR AND ERECTOR**

PROJECT OWNER : HP NAREF, 1250 MARYLAND HOLDINGS 1 LP.			
PROJECT DESCRIPTION : 1250 MARYLAND AVENUE			
PROJECT ADDRESS : 1250 MARYLAND AVENUE, WASHINGTON, DC 20024			
CONTRACTOR : IRON FABRICATION SERVICES, INC.			
DRAWN BY : JSV	DATE : 02-27-2025	PROJ. NO. : 25001	REV # 
CHECKED BY : MNK	DATE : 02-27-2025	DWG NO. : E4801	
DWG DESCRIPTION : PARTIAL LEVEL-10 FRAMING PLAN (PHASE-8) (SEQ#48)			

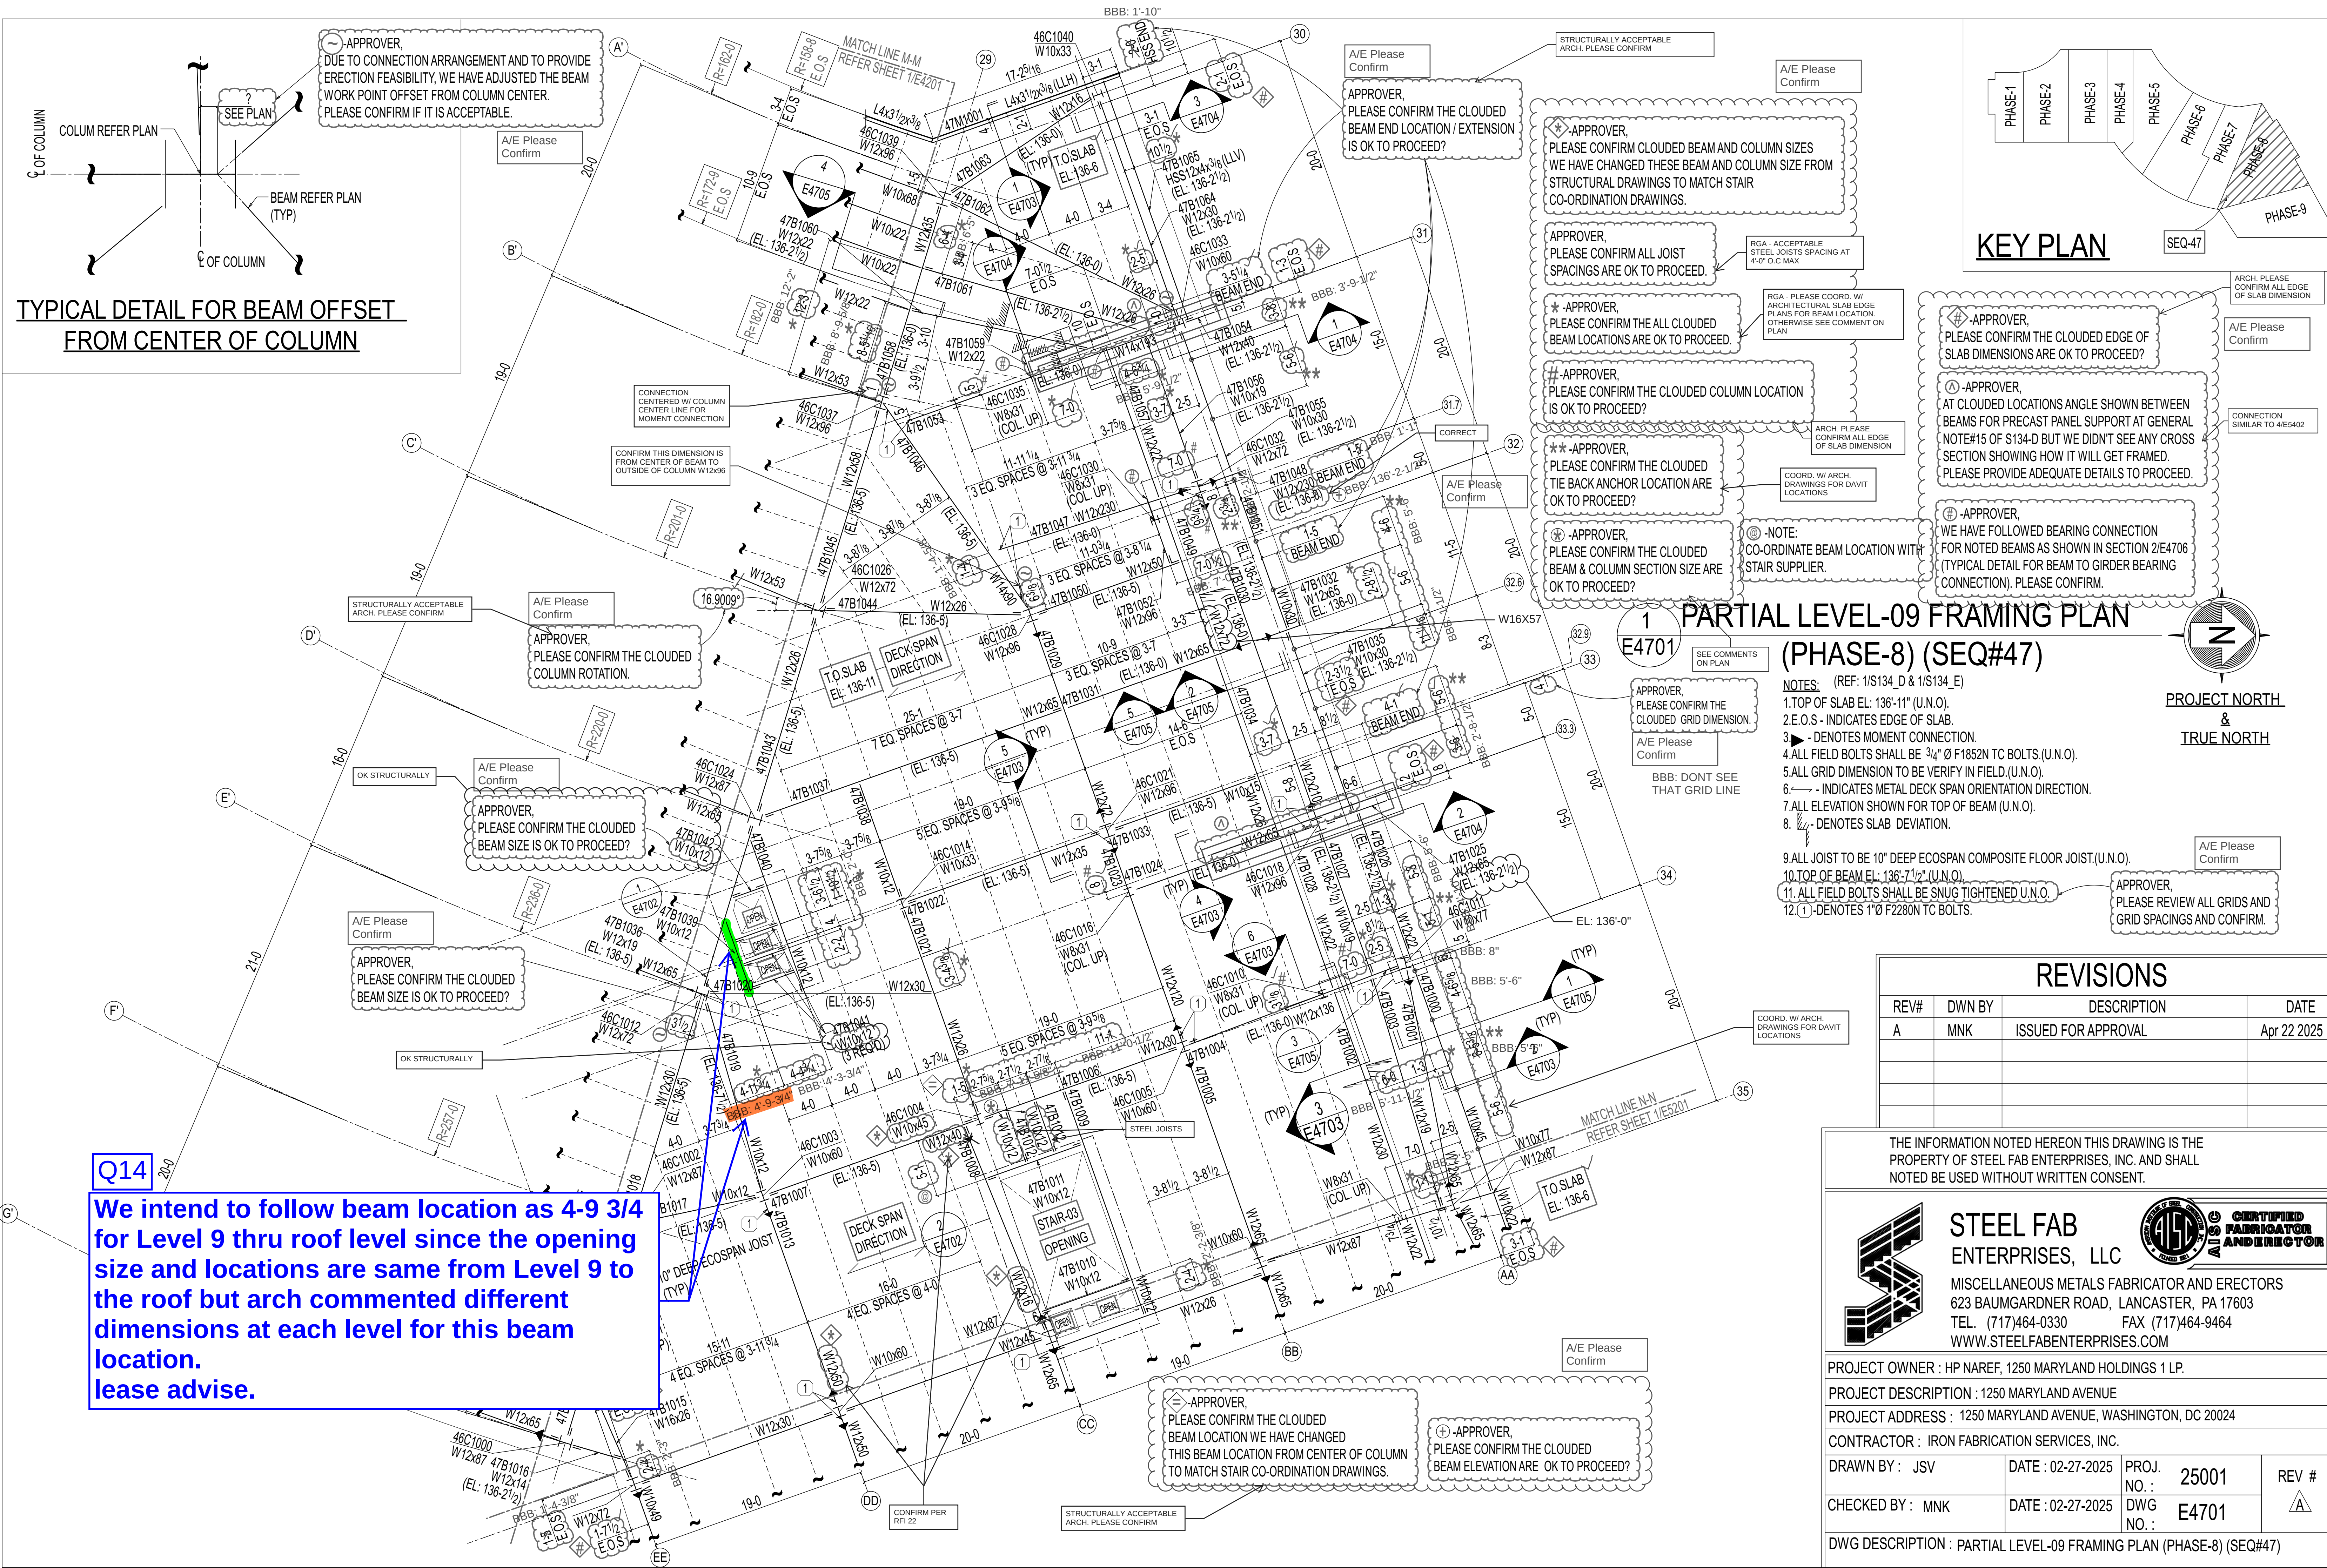

TYPICAL DETAIL FOR BEAM OFFSET FROM CENTER OF COLUMN

KEY PLAN


PARTIAL LEVEL-09 FRAMING PLAN (PHASE-8) (SEQ#47)

- NOTES: (REF: 1/S134_D & 1/S134_E)
- 1.TOP OF SLAB EL: 136'-11" (U.N.O).
 - 2.E.O.S - INDICATES EDGE OF SLAB.
 - 3 - DENOTES MOMENT CONNECTION.
 - 4.ALL FIELD BOLTS SHALL BE 3/4" Ø F1852N TC BOLTS (U.N.O).
 - 5.ALL GRID DIMENSION TO BE VERIFY IN FIELD (U.N.O).
 - 6 - INDICATES METAL DECK SPAN ORIENTATION DIRECTION.
 - 7.ALL ELEVATION SHOWN FOR TOP OF BEAM (U.N.O).
 - 8 - DENOTES SLAB DEVIATION.
 - 9.ALL JOIST TO BE 10" DEEP ECOSPAN COMPOSITE FLOOR JOIST.(U.N.O).
 - 10.TOP OF BEAM EL: 136'-7 1/2" (U.N.O).
 11. ALL FIELD BOLTS SHALL BE SNUG TIGHTENED U.N.O.
 12. 1 - DENOTES 1"Ø F2280N TC BOLTS.

REVISIONS

REV#	DWN BY	DESCRIPTION	DATE
A	MNK	ISSUED FOR APPROVAL	Apr 22 2025

THE INFORMATION NOTED HEREON THIS DRAWING IS THE PROPERTY OF STEEL FAB ENTERPRISES, INC. AND SHALL NOTED BE USED WITHOUT WRITTEN CONSENT.

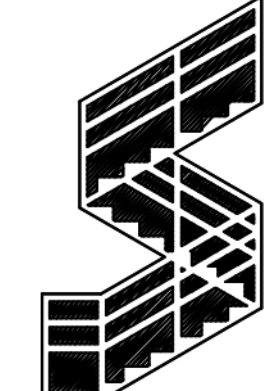

STEEL FAB ENTERPRISES, LLC

MISCELLANEOUS METALS FABRICATOR AND ERECTORS

623 BAUMGARDNER ROAD, LANCASTER, PA 17603

TEL. (717)464-0330 FAX (717)464-9464

WWW.STEELFABENTERPRISES.COM



CERTIFIED FABRICATOR AND ERECTOR


PROJECT OWNER : HP NAREF, 1250 MARYLAND HOLDINGS 1 LP.			
PROJECT DESCRIPTION : 1250 MARYLAND AVENUE			
PROJECT ADDRESS : 1250 MARYLAND AVENUE, WASHINGTON, DC 20024			
CONTRACTOR : IRON FABRICATION SERVICES, INC.			
DRAWN BY : JSV	DATE : 02-27-2025	PROJ. NO. : 25001	REV #
CHECKED BY : MNK	DATE : 02-27-2025	DWG NO. : E4701	A
DWG DESCRIPTION : PARTIAL LEVEL-09 FRAMING PLAN (PHASE-8) (SEQ#47)			

Q14

We intend to follow beam location as 4-9 3/4 for Level 9 thru roof level since the opening size and locations are same from Level 9 to the roof but arch commented different dimensions at each level for this beam location. lease advise.

Q15

We intend to follow the beam extension as 2'-0" from grid '30' instead of 1'-10" to bear the edge of slab support angle as shown in snap#02. Please confirm.

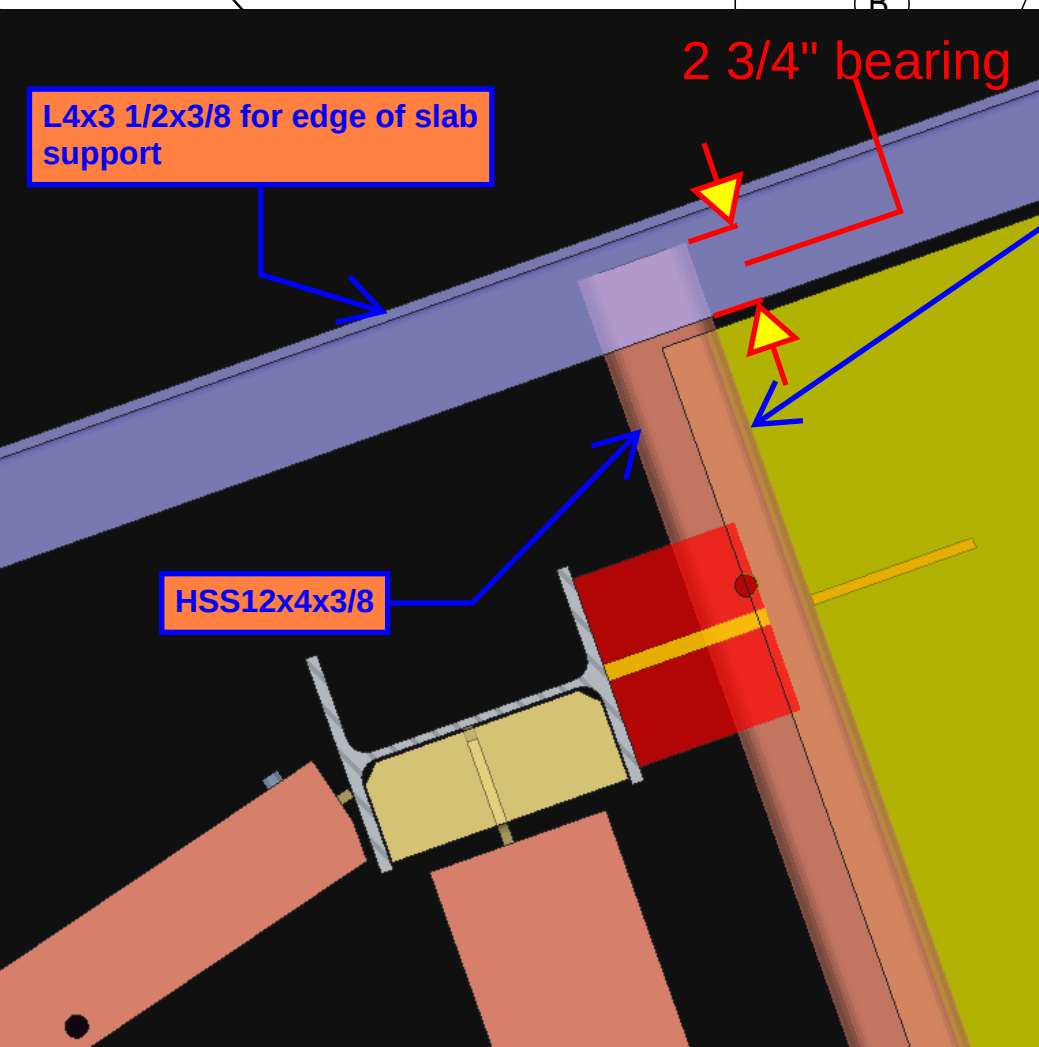

Snap#02 from model

Q16

Arch, Please confirm the magenta clouded beam end location is OK to proceed?

KEY PLAN

PHASE-1 PHASE-2 PHASE-3 PHASE-4 PHASE-5 PHASE-6 PHASE-7 PHASE-8 PHASE-9

SEQ-47

PARTIAL

Snap from Arch. drawing 1/A002 (grid plan)

Q17

Please confirm the yellow clouded grid 32.9 location from 33.

Q18

Please confirm the green clouded beam location 3-6 from grid "AA" is OK to proceed?

Q19

We intend to ignore the cyan clouded arch's dimension 7-8 since at phase#7 BFA sheet, arch commented 2-7 & we will follow 2-7 for the same & ignore 7-8.

Please advise.

- NOTES: (REF: 1/S134_D & 1/S134_E)
- 1.TOP OF SLAB EL: 136'-11" (U.N.O).
 - 2.E.O.S - INDICATES EDGE OF SLAB.
 3. - DENOTES MOMENT CONNECTION.
 - 4.ALL FIELD BOLTS SHALL BE 3/4" Ø F1552N TC BOLTS.(U.N.O).
 - 5.ALL GRID DIMENSION TO BE VERIFY IN FIELD.(U.N.O).
 6. - INDICATES METAL DECK SPAN ORIENTATION DIRECTION.
 - 7.ALL ELEVATION SHOWN FOR TOP OF BEAM.(U.N.O).
 8. - DENOTES SLAB DEVIATION.
 - 9.ALL JOIST TO BE 10" DEEP ECOSPAN
 - 10.TOP OF BEAM EL: 136'-7 1/2" (U.N.O)
 11. ALL FIELD BOLTS SHALL BE SNI
 12. - DENOTES 1"Ø F2280N TC BO

REVISIONS

REV#	DWN BY	DESCRIPTION	DATE
1	MMK	ISSUED FOR APPROVAL	Apr 22 2025


THE INFORMATION NOTED HEREON THIS DRAWING IS THE PROPERTY OF STEEL FAB ENTERPRISES, INC. AND SHALL NOT BE USED WITHOUT WRITTEN CONSENT.



STEEL FAB ENTERPRISES, LLC
MISCELLANEOUS METALS FABRICATOR AND ERECTORS
623 BAUMGARDNER ROAD, LANCASTER, PA 17603
TEL. (717)464-0330 FAX (717)464-9464
WWW.STEELFABENTERPRISES.COM




PROJECT OWNER : HP NAREF, 1250 MARYLAND HOLDINGS 1 LP.			
PROJECT DESCRIPTION : 1250 MARYLAND AVENUE			
PROJECT ADDRESS : 1250 MARYLAND AVENUE, WASHINGTON, DC 20024			
CONTRACTOR : IRON FABRICATION SERVICES, INC.			
DRAWN BY : JSV	DATE : 02-27-2025	PROJ. NO. : 25001	REV #
CHECKED BY : MNK	DATE : 02-27-2025	DWG NO. : E4701	Δ
DWG DESCRIPTION : PARTIAL LEVEL-09 FRAMING PLAN (PHASE-8) (SEQ#47)			

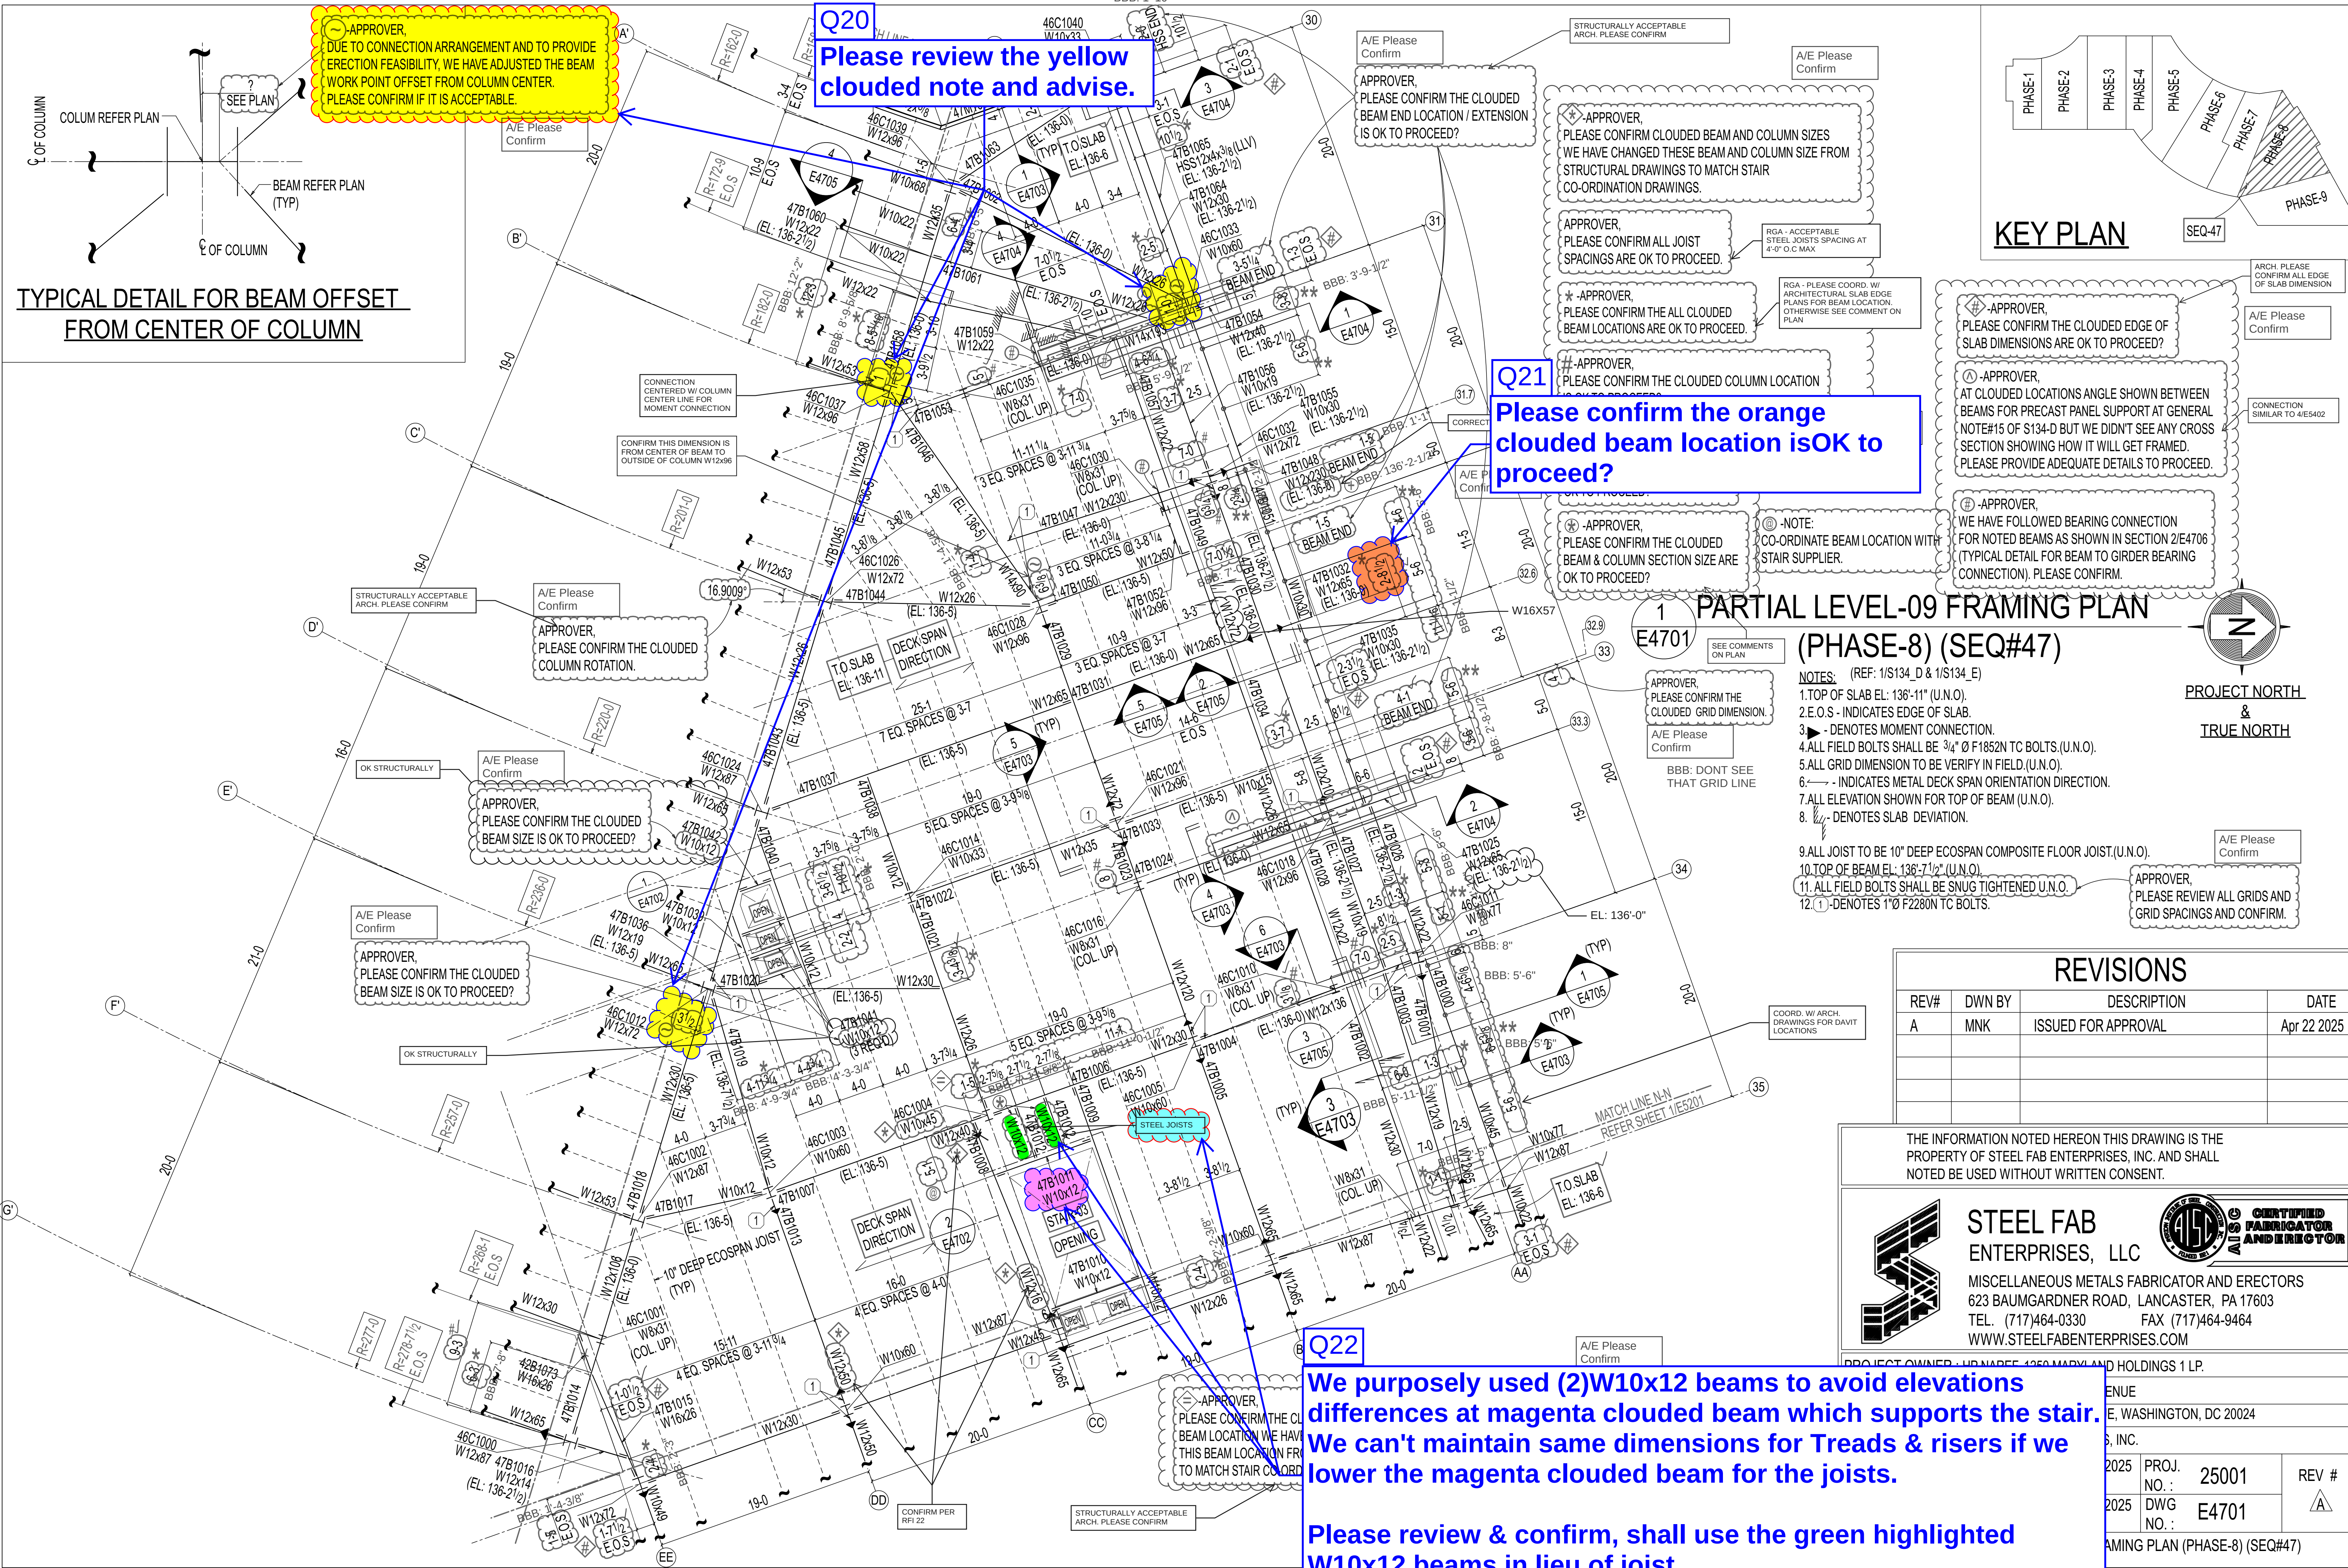

TYPICAL DETAIL FOR BEAM OFFSET FROM CENTER OF COLUMN

KEY PLAN

PARTIAL LEVEL-09 FRAMING PLAN (PHASE-8) (SEQ#47)

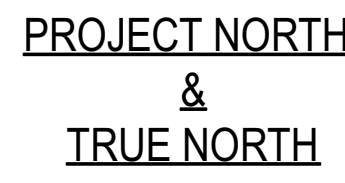


- NOTES: (REF: 1/S134_D & 1/S134_E)
- 1.TOP OF SLAB EL: 136'-11" (U.N.O).
 - 2.E.O.S - INDICATES EDGE OF SLAB.
 - 3. - DENOTES MOMENT CONNECTION.
 - 4.ALL FIELD BOLTS SHALL BE 3/4" Ø F1852N TC BOLTS (U.N.O).
 - 5.ALL GRID DIMENSION TO BE VERIFY IN FIELD (U.N.O).
 - 6. - INDICATES METAL DECK SPAN ORIENTATION DIRECTION.
 - 7.ALL ELEVATION SHOWN FOR TOP OF BEAM (U.N.O).
 - 8. - DENOTES SLAB DEVIATION.
 - 9.ALL JOIST TO BE 10" DEEP ECOSPAN COMPOSITE FLOOR JOIST (U.N.O).
 - 10.TOP OF BEAM EL: 136'-7 1/2" (U.N.O).
 - 11. ALL FIELD BOLTS SHALL BE SNUG TIGHTENED U.N.O.
 - 12. (1) - DENOTES 1" Ø F2280N TC BOLTS.

REVISIONS

REV#	DWN BY	DESCRIPTION	DATE
A	MNK	ISSUED FOR APPROVAL	Apr 22 2025

THE INFORMATION NOTED HEREON THIS DRAWING IS THE PROPERTY OF STEEL FAB ENTERPRISES, INC. AND SHALL NOTED BE USED WITHOUT WRITTEN CONSENT.

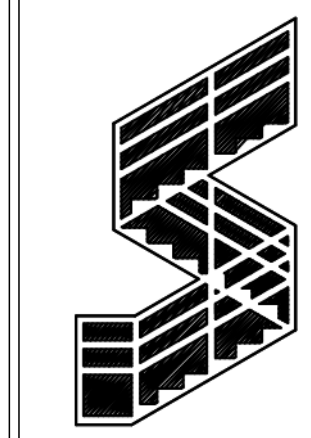

STEEL FAB ENTERPRISES, LLC
MISCELLANEOUS METALS FABRICATOR AND ERECTORS
623 BAUMGARDNER ROAD, LANCASTER, PA 17603
TEL. (717)464-0330 FAX (717)464-9464
WWW.STEELFABENTERPRISES.COM







PROJECT OWNER: URBANPEE 1250 MARK AND HOLDINGS 1 LP.			
VENUE			
E, WASHINGTON, DC 20024			
S, INC.			
2025	PROJ. NO. :	25001	REV #
2025	DWG NO. :	E4701	A
FRAMING PLAN (PHASE-8) (SEQ#47)			

Q20
Please review the yellow clouded note and advise.

Q21
Please confirm the orange clouded beam location is OK to proceed?

Q22
We purposely used (2)W10x12 beams to avoid elevations differences at magenta clouded beam which supports the stair. We can't maintain same dimensions for Treads & risers if we lower the magenta clouded beam for the joists.

Please review & confirm, shall use the green highlighted W10x12 beams in lieu of joist.

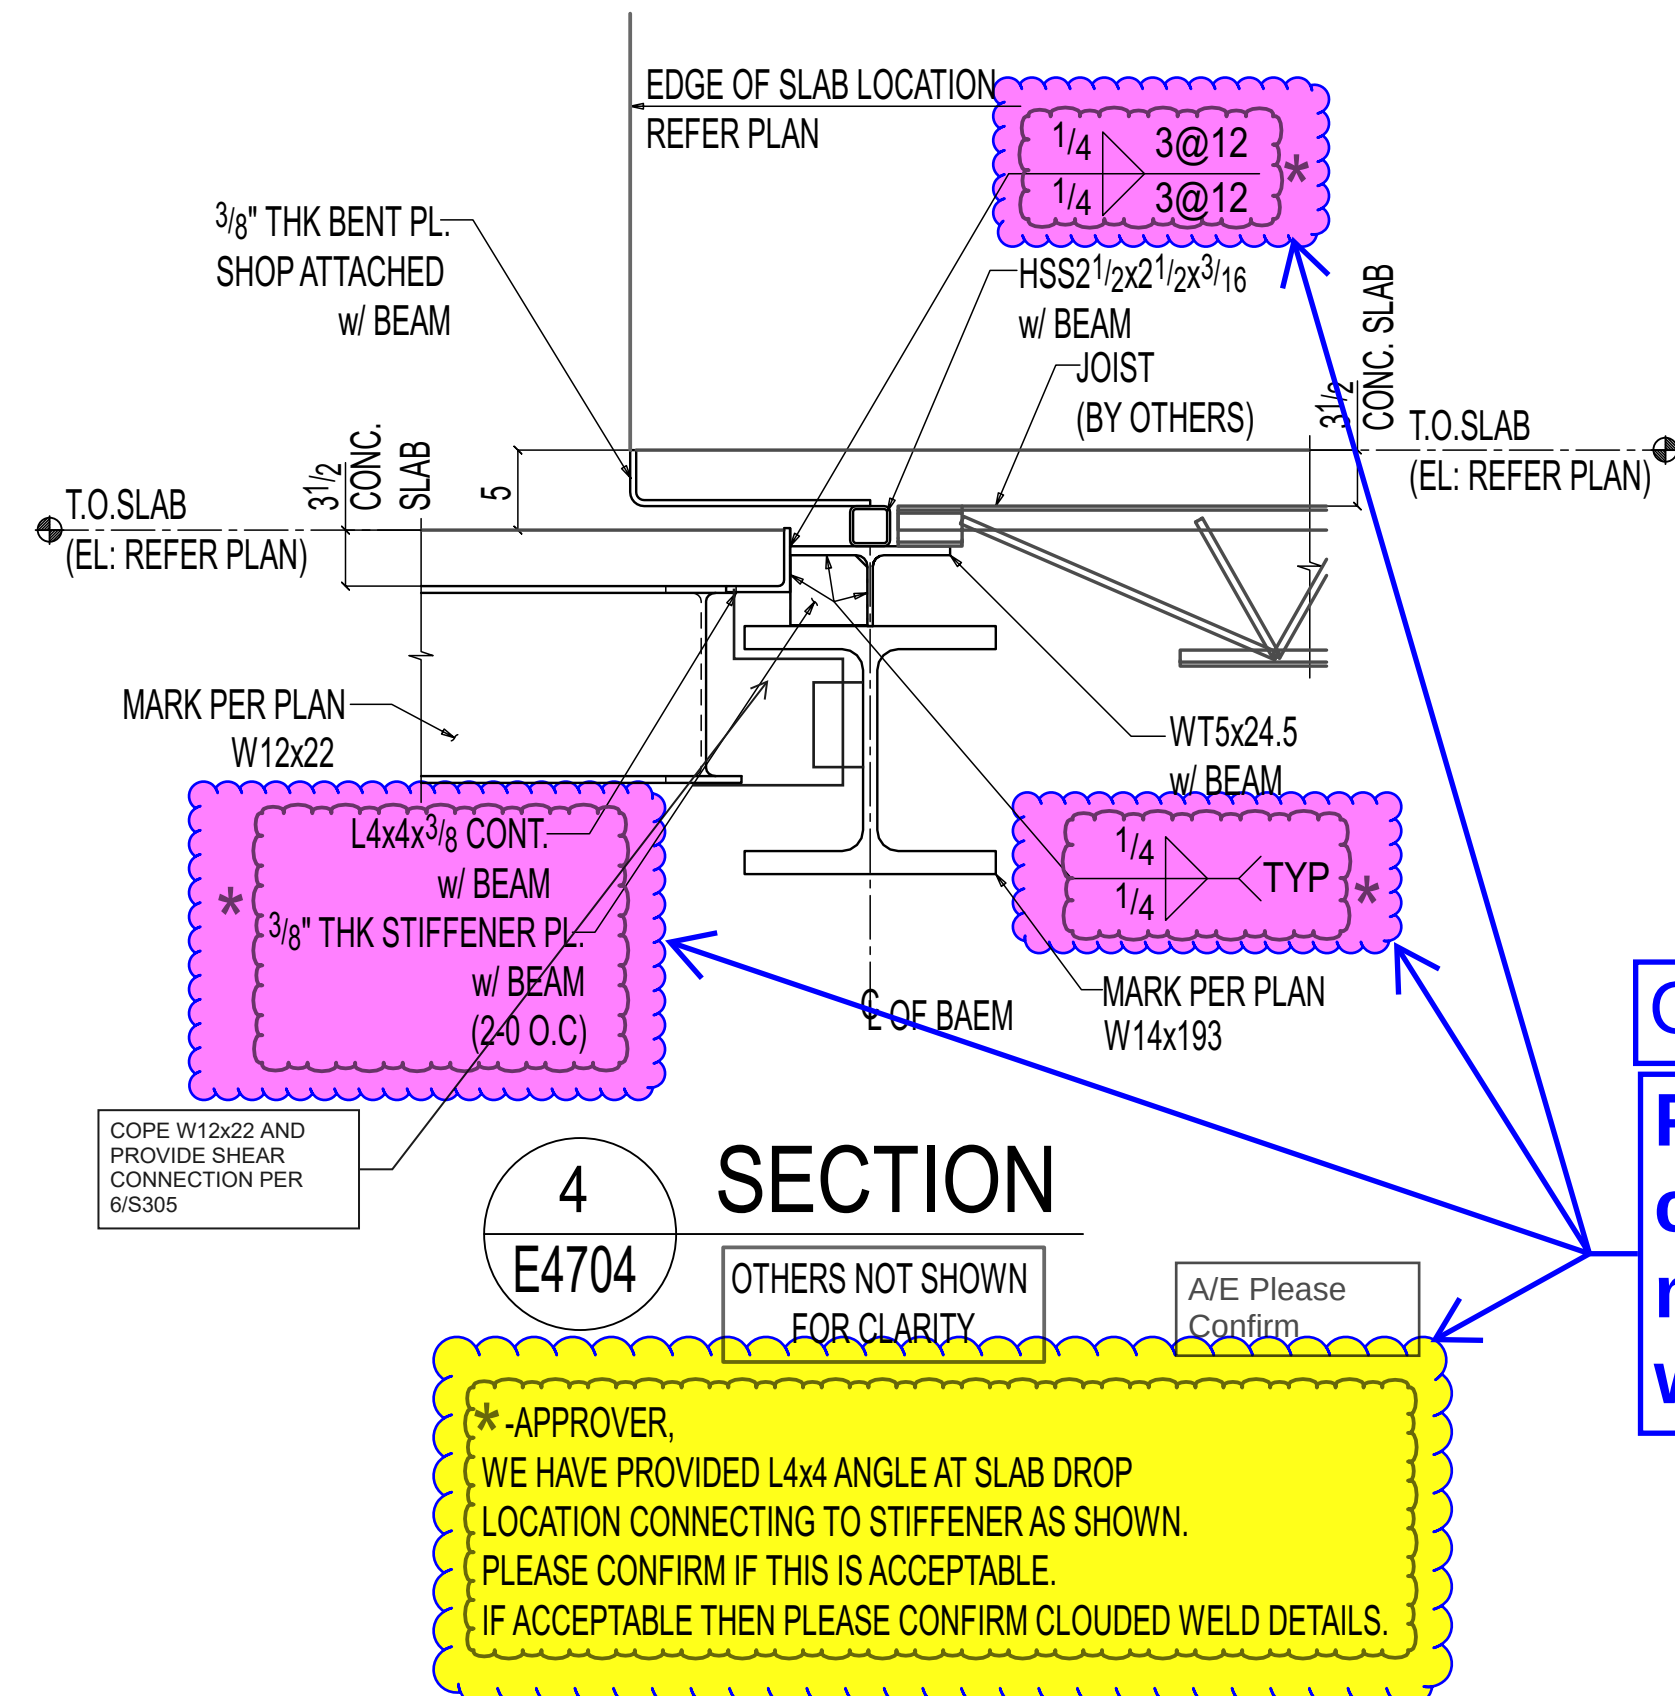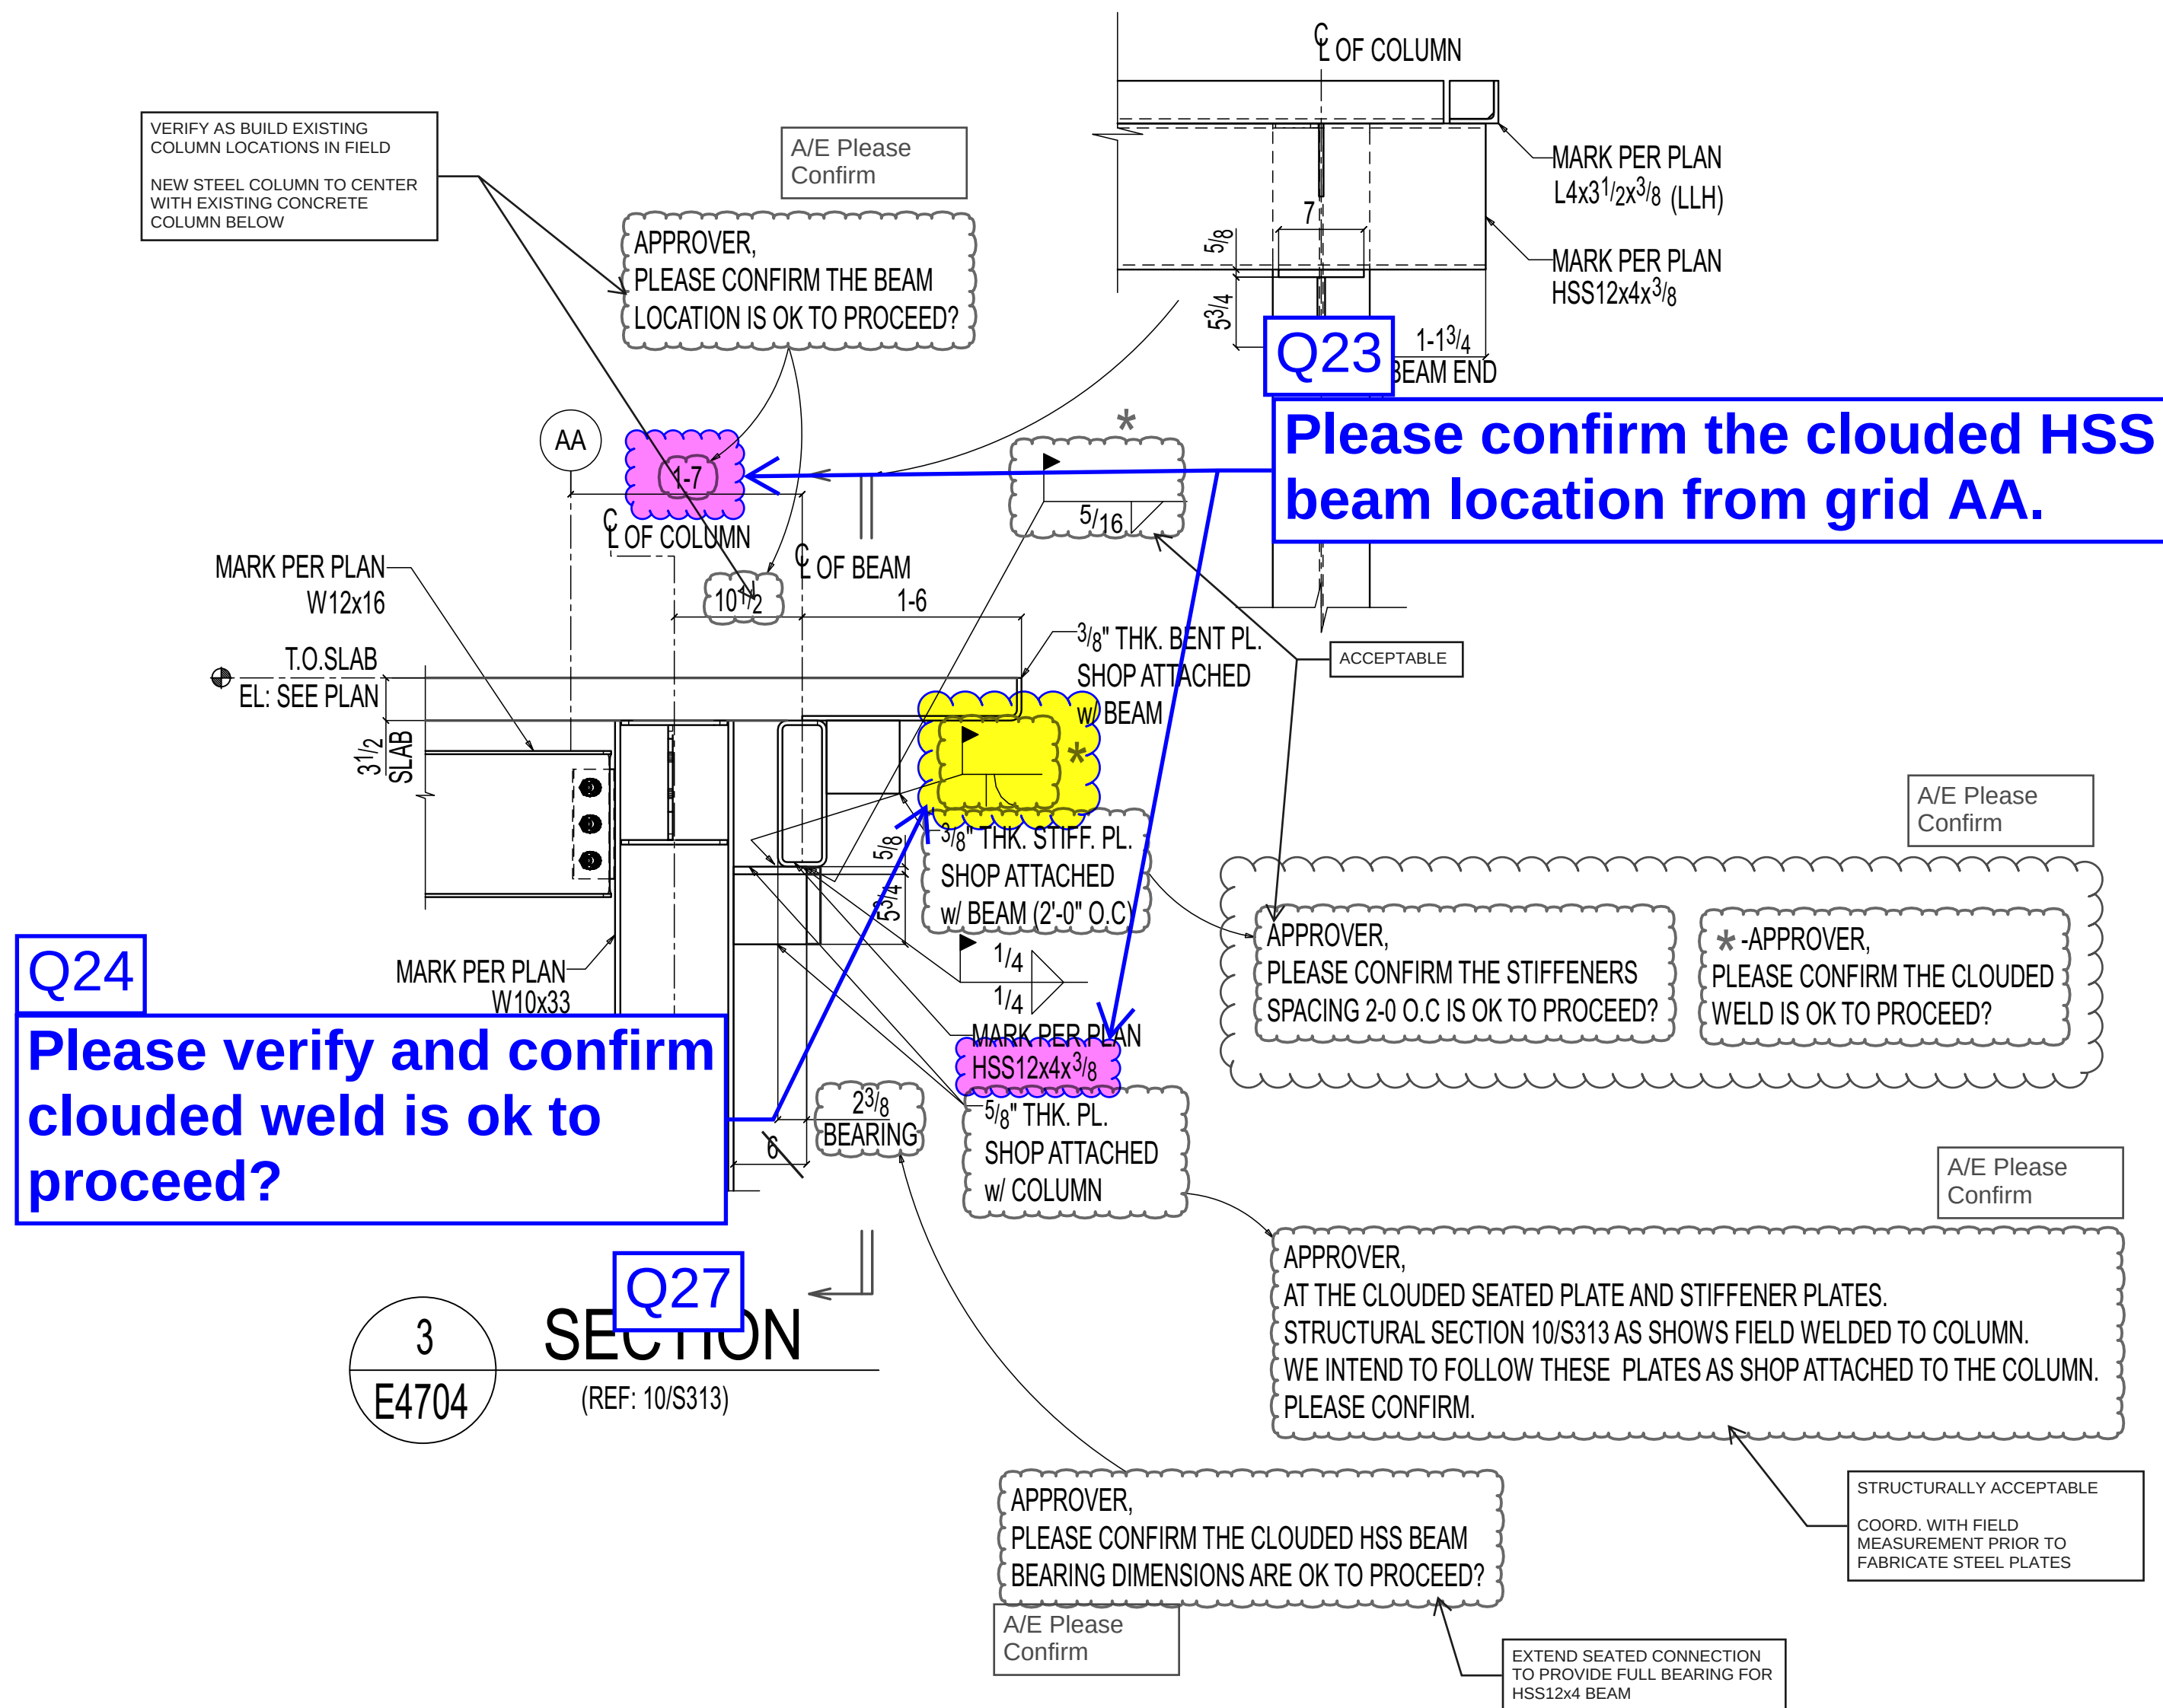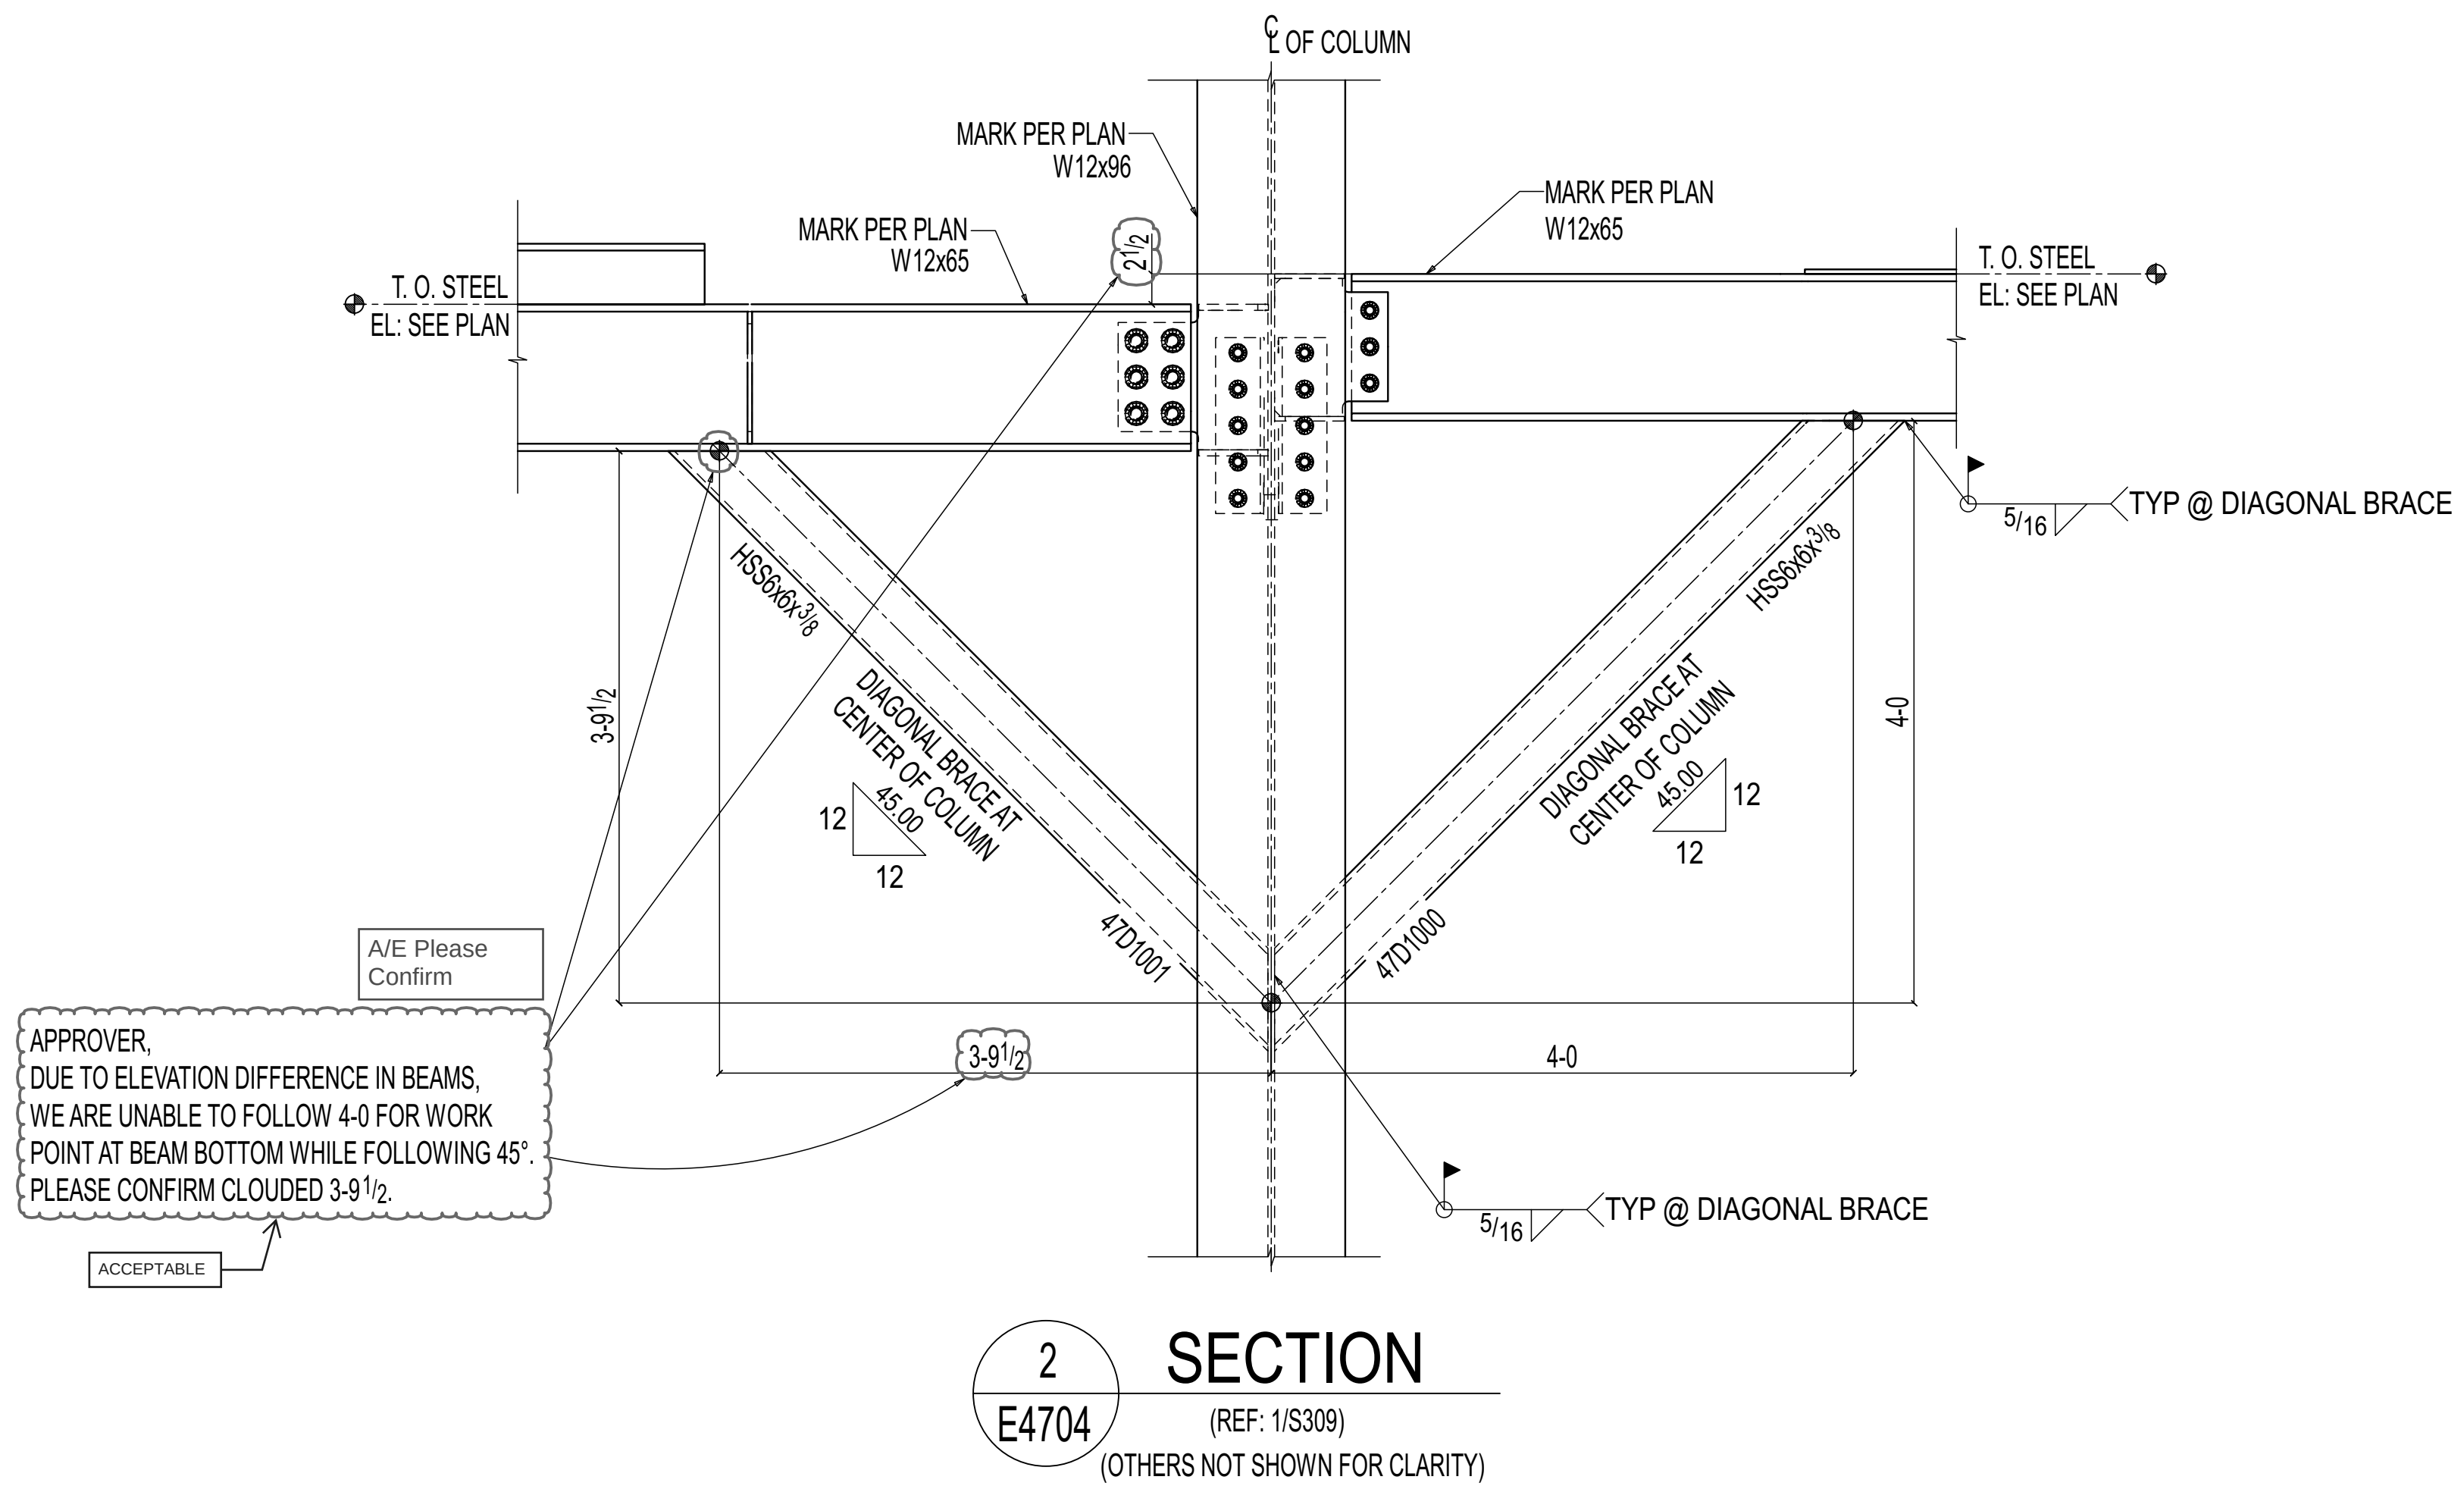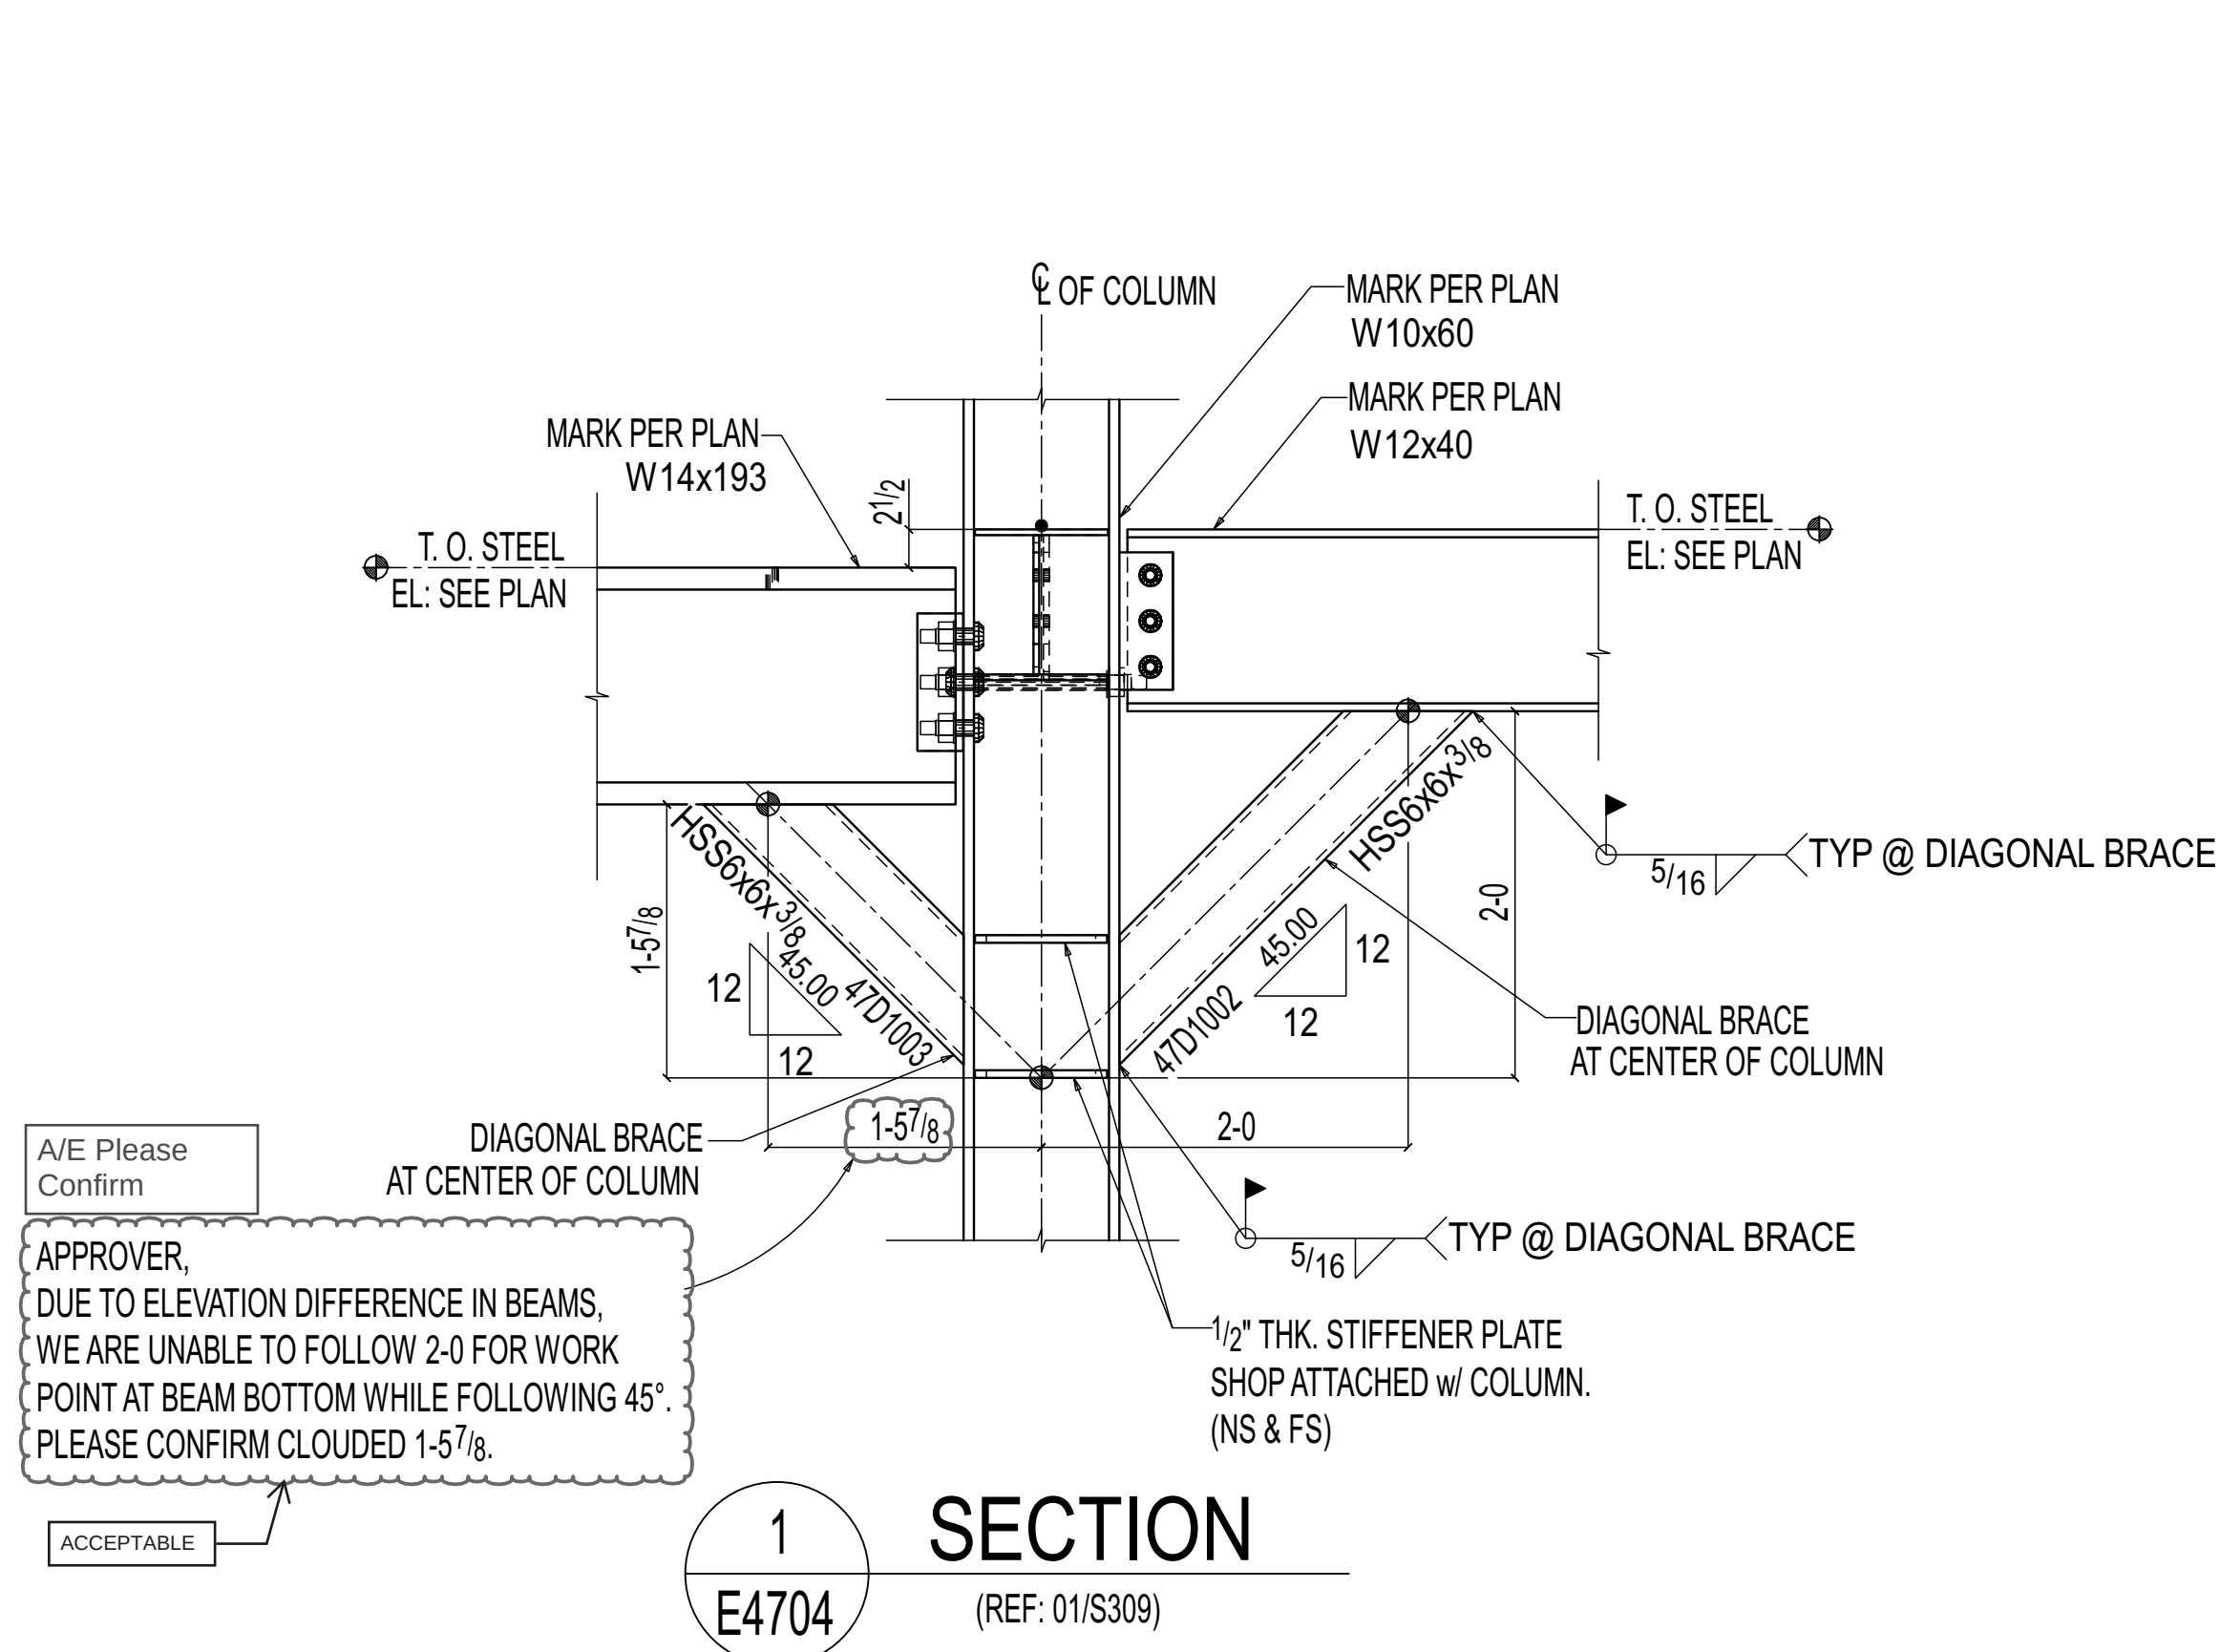

REVISIONS			
REV#	DWN BY	DESCRIPTION	DATE
A	MNK	ISSUED FOR APPROVAL	Apr 22 2025



THE INFORMATION NOTED HEREON THIS DRAWING IS THE PROPERTY OF STEEL FAB ENTERPRISES, INC. AND SHALL NOTED BE USED WITHOUT WRITTEN CONSENT.



STEEL FAB ENTERPRISES, LLC
MISCELLANEOUS METALS FABRICATOR AND ERECTORS
17464-0330 FAX (717)464-9464
TEELFABENTERPRISES.COM
1250 MARYLAND HOLDINGS 1 LP.
MARYLAND AVENUE
MARYLAND AVENUE, WASHINGTON, DC 20024




CONTRACTOR : IRON FABRICATION SERVICES, INC.			
DRAWN BY : JSV	DATE : 02-27-2025	PROJ. NO. : 25001	REV # 
CHECKED BY : MNK	DATE : 02-27-2025	DWG NO. : E4704	
DWG DESCRIPTION : SECTIONS			

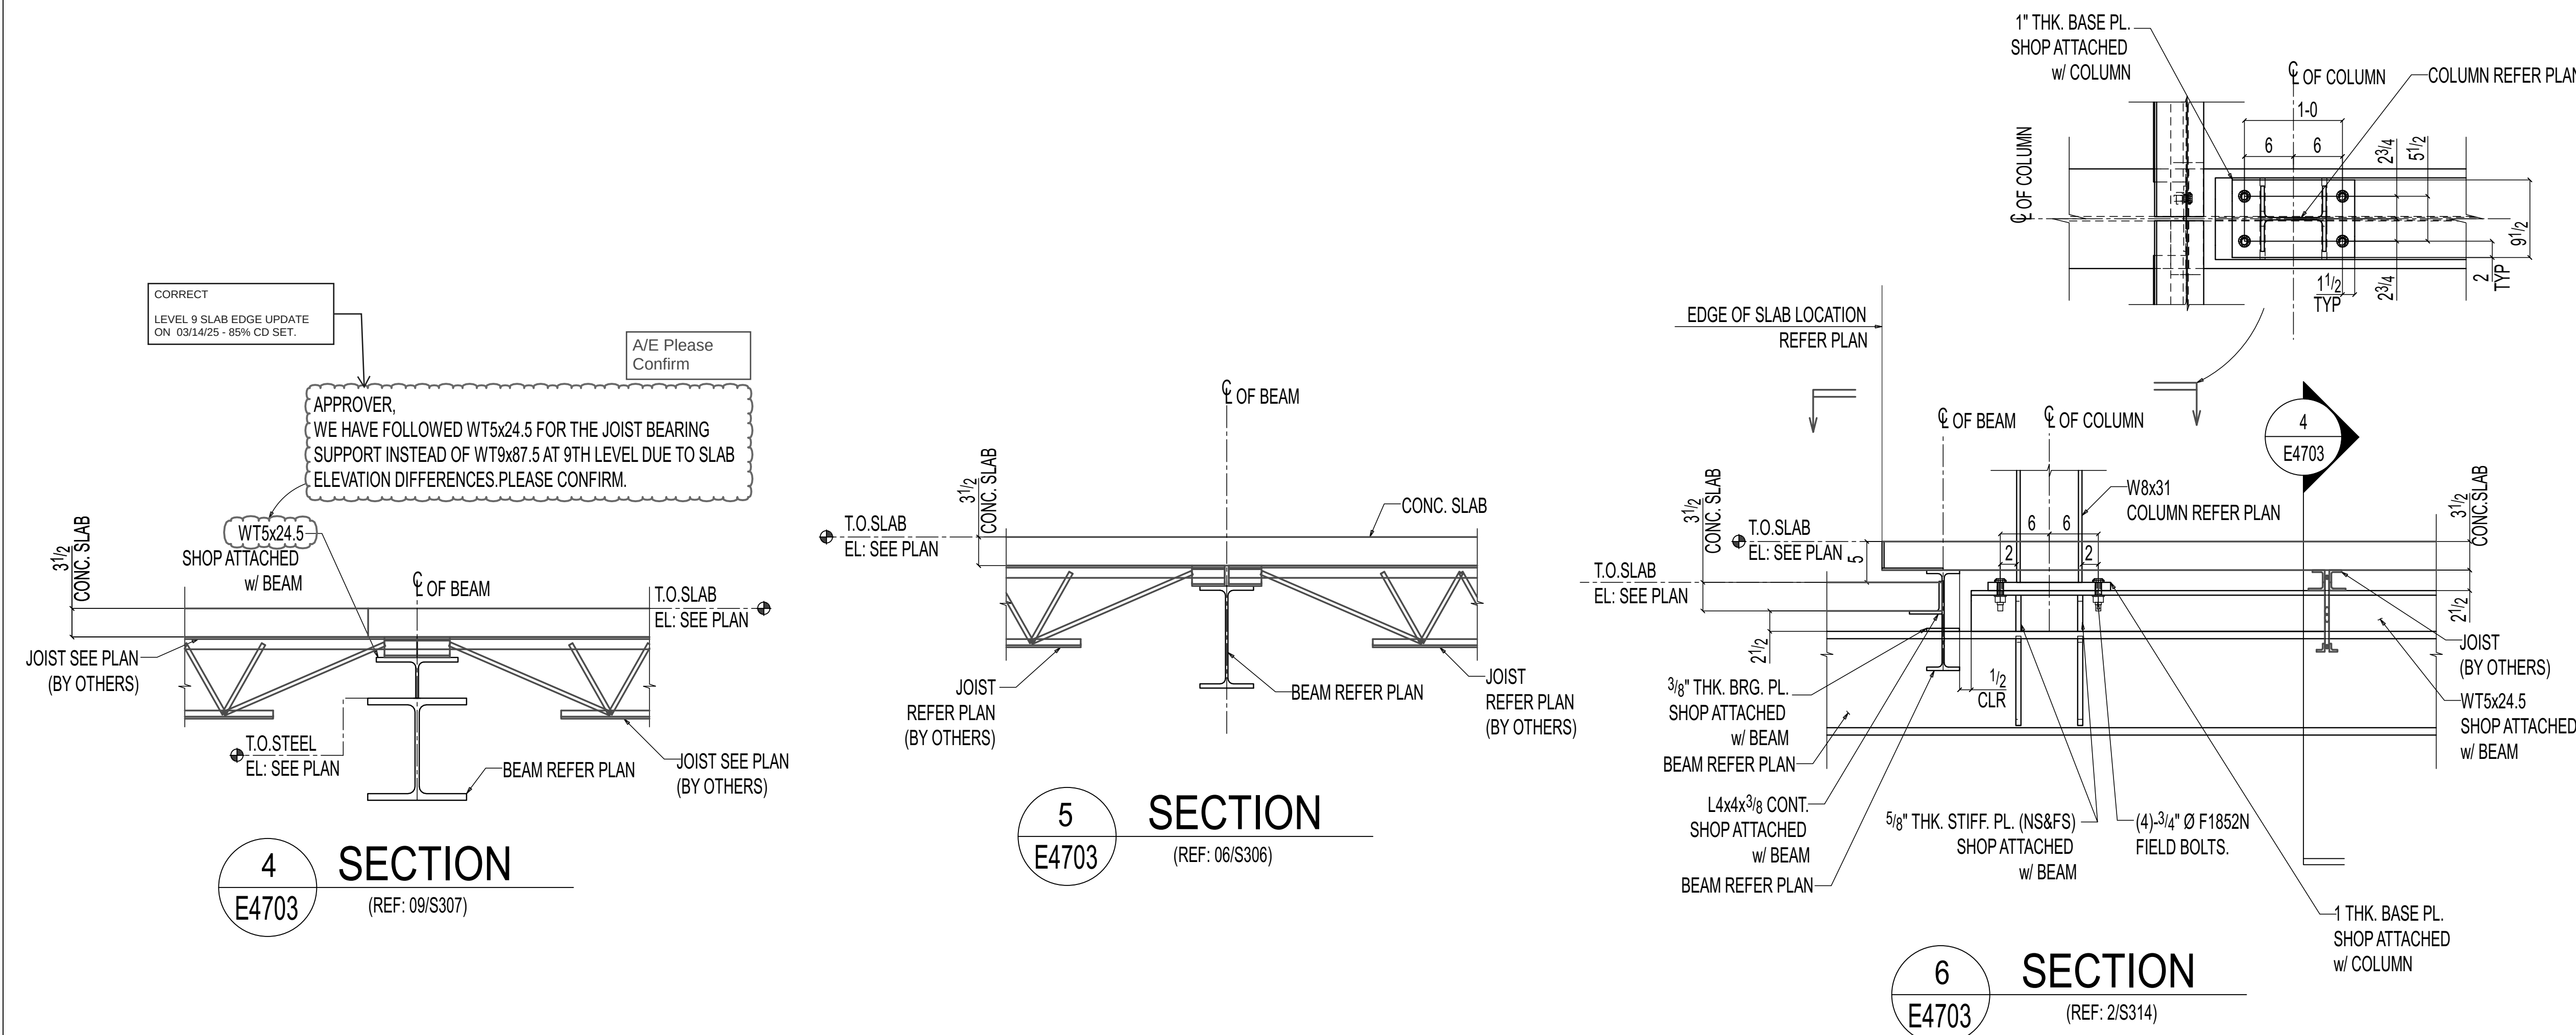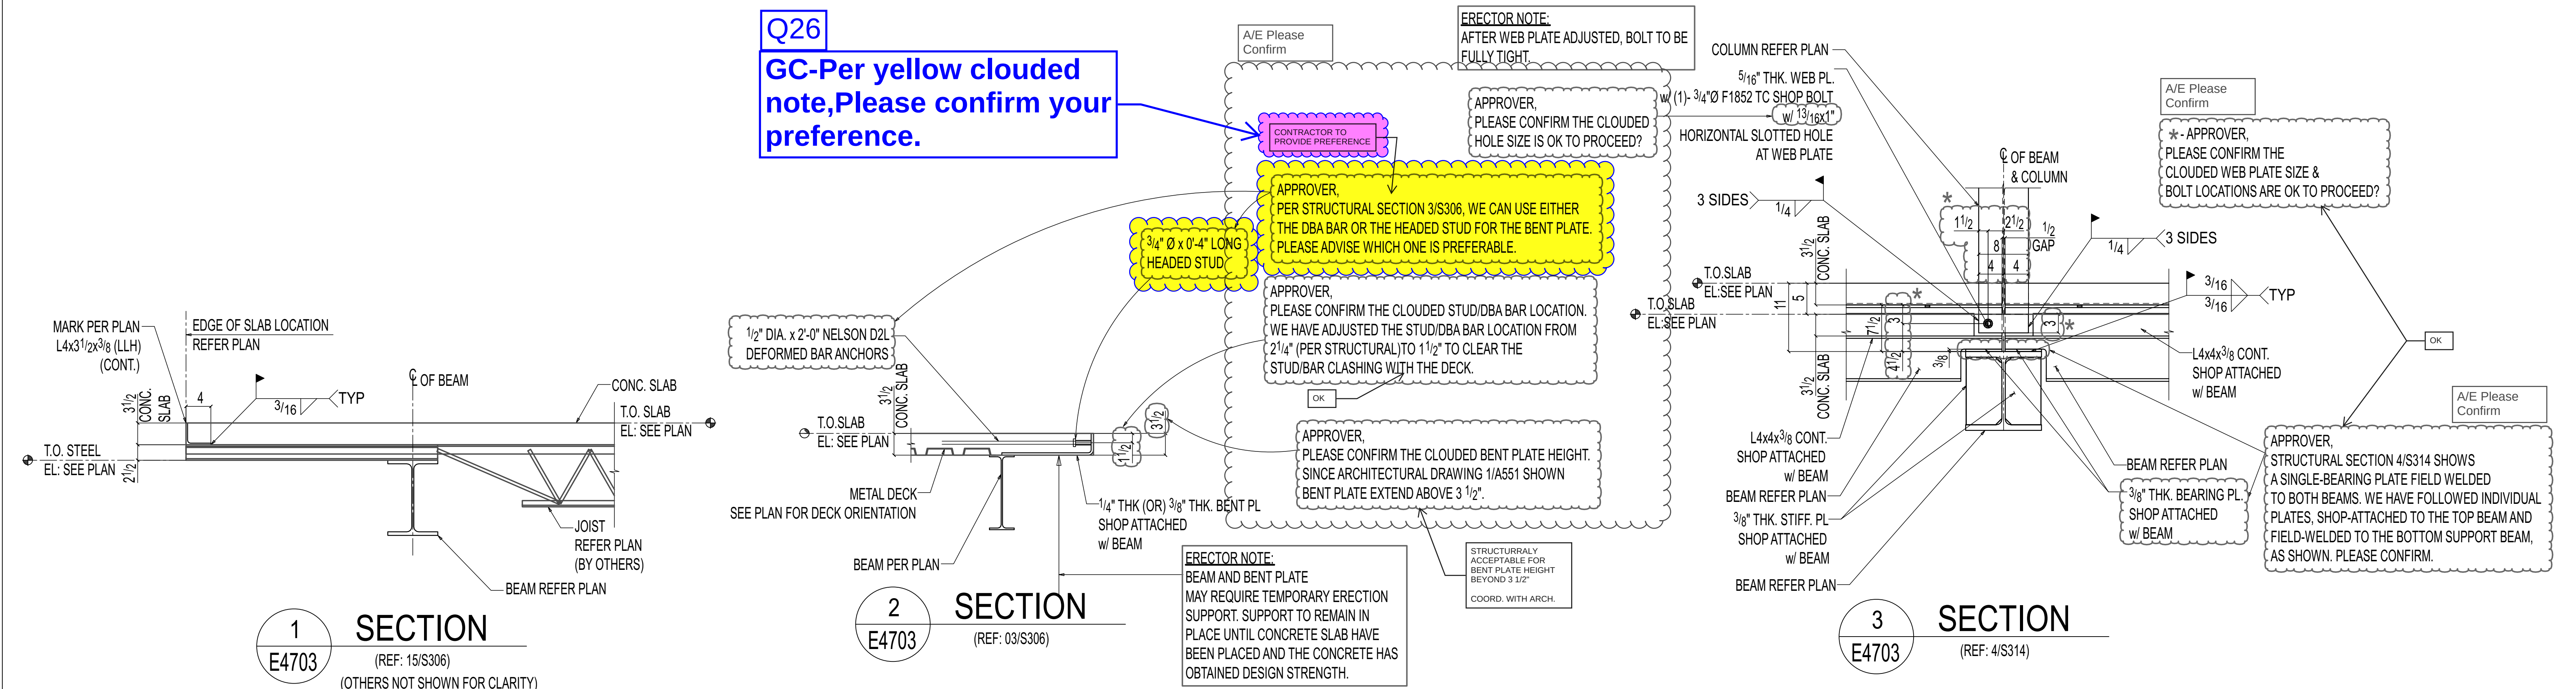

REVISIONS			
REV#	DWN BY	DESCRIPTION	DATE
A	MNK	ISSUED FOR APPROVAL	Apr 22 2025


THE INFORMATION NOTED HEREON THIS DRAWING IS THE PROPERTY OF STEEL FAB ENTERPRISES, INC. AND SHALL NOTED BE USED WITHOUT WRITTEN CONSENT.

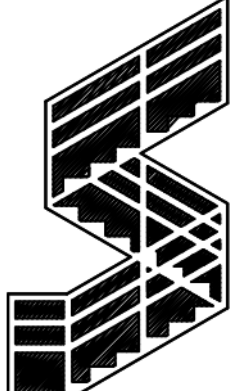

STEEL FAB ENTERPRISES, LLC
MISCELLANEOUS METALS FABRICATOR AND ERECTORS
623 BAUMGARDNER ROAD, LANCASTER, PA 17603
TEL. (717)464-0330 FAX (717)464-9464
WWW.STEELFABENTERPRISES.COM



PROJECT OWNER : HP NAREF, 1250 MARYLAND HOLDINGS 1 LP.			
PROJECT DESCRIPTION : 1250 MARYLAND AVENUE			
PROJECT ADDRESS : 1250 MARYLAND AVENUE, WASHINGTON, DC 20024			
CONTRACTOR : IRON FABRICATION SERVICES, INC.			
DRAWN BY : JSV	DATE : 02-27-2025	PROJ. NO. : 25001	REV # 
CHECKED BY : MNK	DATE : 02-27-2025	DWG NO. : E4703	
DWG DESCRIPTION : SECTIONS			

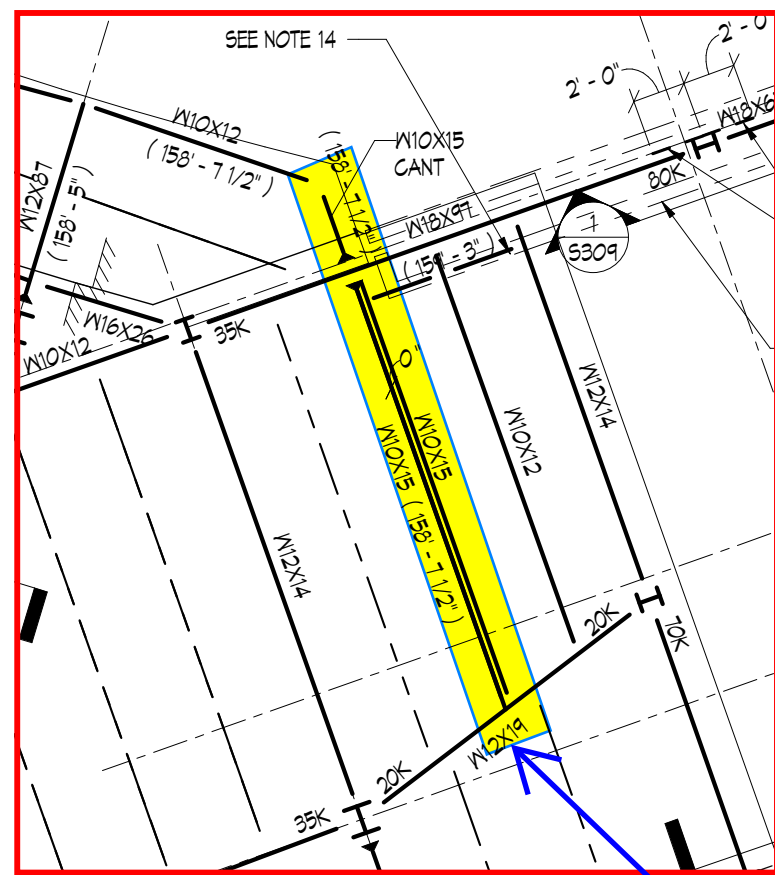


Snap from structural drawing (1/S136_D)

Q27

We have followed the edge of slab dimension 0'-3" from grid 31 per latest architectural drawing 2/A057 in lieu of 8" marked by Arch. Please confirm.

TYPICAL DETAIL FOR BEAM OFFSET FROM CENTER OF COLUMN

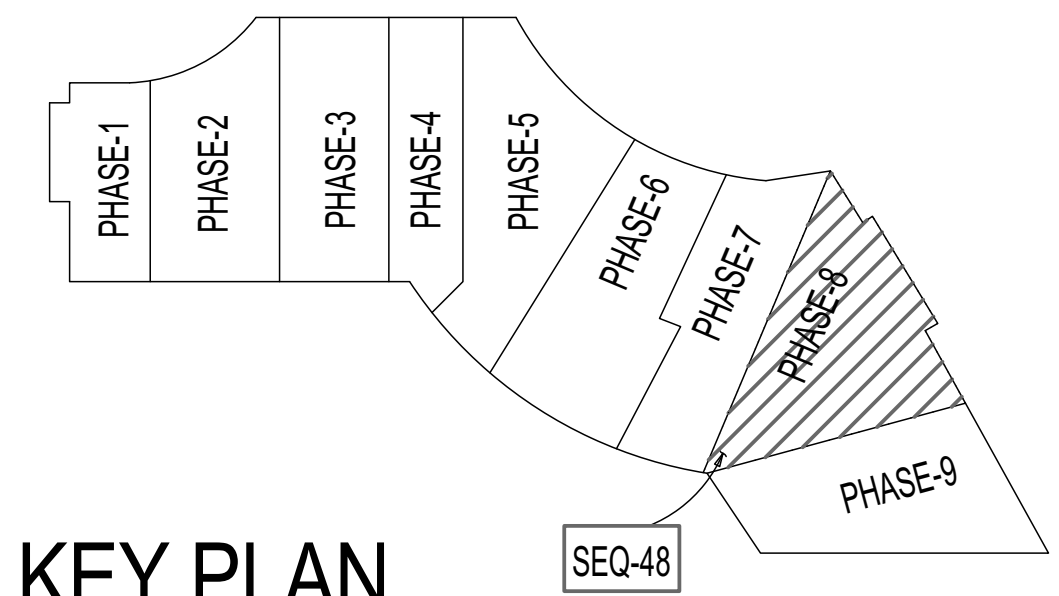

KEY PLAN

Q28

We assumed green clouded dimension should be 6-9 as it is. If the yellow clouded cantilever beam also need to moved to match the 6-6 which supersedes the condition that all beam center along edge of slab should be located 1-0 from edge of slab.

Please review & confirm shall we use 6-9"?

Snap from Arch. drawing (2/A057)

LEVEL-10 FRAMING PLAN (PHASE-8)-(SEQ#48)

(REF: 1/S135_D & 1/S135_E)



1. APPROVER, DUE TO CONNECTION ARRANGEMENT AND TO PROVIDE ERECTION FEASIBILITY, WE HAVE ADJUSTED THE BEAM WORK POINT OFFSET FROM COLUMN CENTER. PLEASE CONFIRM IF IT IS ACCEPTABLE.
2. APPROVER, PLEASE CONFIRM ALL JOIST SPACINGS ARE OK TO PROCEED?
3. APPROVER, PLEASE CONFIRM ALL CLOUDED BEAM LOCATIONS ARE OK TO PROCEED?
4. APPROVER, PLEASE CONFIRM THE CLOUDED COLUMN LOCATIONS ARE OK TO PROCEED?
5. APPROVER, PLEASE CONFIRM THE CLOUDED BEAM SECTION SIZE IS OK TO PROCEED?
6. APPROVER, PLEASE CONFIRM THE CLOUDED BEAM ELEVATION IS OK TO PROCEED?
7. APPROVER, PLEASE CONFIRM THE CLOUDED BEAM END DIMENSION IS OK TO PROCEED?
8. APPROVER, PLEASE CONFIRM THE CLOUDED BEAM LOCATION WE HAVE CHANGED THIS BEAM LOCATION FROM CENTER OF COLUMN TO MATCH STAIR CO-ORDINATION DRAWINGS.
9. APPROVER, PLEASE CONFIRM THE CLOUDED BEAM LOCATION WE HAVE CHANGED THIS BEAM LOCATION FROM CENTER OF COLUMN TO MATCH STAIR CO-ORDINATION DRAWINGS.
10. APPROVER, PLEASE CONFIRM THE CLOUDED BEAM LOCATION WE HAVE CHANGED THIS BEAM LOCATION FROM CENTER OF COLUMN TO MATCH STAIR CO-ORDINATION DRAWINGS.
11. APPROVER, PLEASE CONFIRM THE CLOUDED BEAM LOCATION WE HAVE CHANGED THIS BEAM LOCATION FROM CENTER OF COLUMN TO MATCH STAIR CO-ORDINATION DRAWINGS.

Q29

Please confirm the magenta clouded beam's section size are OK to proceed?

REVISIONS

REV#	DWN BY	DESCRIPTION	DATE
A	MNK	ISSUED FOR APPROVAL	Apr 22 2025

THE INFORMATION NOTED HEREON THIS DRAWING IS THE PROPERTY OF STEEL FAB ENTERPRISES, INC. AND SHALL NOTED BE USED WITHOUT WRITTEN CONSENT.



STEEL FAB ENTERPRISES, LLC

MISCELLANEOUS METALS FABRICATOR AND ERECTORS
623 BAUMGARDNER ROAD, LANCASTER, PA 17603
TEL. (717)464-0330 FAX (717)464-9464
WWW.STEELFABENTERPRISES.COM



PROJECT OWNER : HP NAREF, 1250 MARYLAND HOLDINGS 1 LP.

PROJECT DESCRIPTION : 1250 MARYLAND AVENUE

PROJECT ADDRESS : 1250 MARYLAND AVENUE, WASHINGTON, DC 20024

CONTRACTOR : IRON FABRICATION SERVICES, INC.


DRAWN BY : JSV	DATE : 02-27-2025	PROJ. NO. : 25001	REV #
CHECKED BY : MNK	DATE : 02-27-2025	DWG NO. : E4801	A

DWG DESCRIPTION : PARTIAL LEVEL-10 FRAMING PLAN (PHASE-8) (SEQ#48)

Q31

We purposely used W10x12 beam to avoid elevations differences at green highlighted beam which supports the stair. We can't maintain same dimensions for Treads & risers if we lower the green highlighted beam for the joists.

Please review & confirm, shall use the magenta highlighted W10x12 beam in lieu of joist?

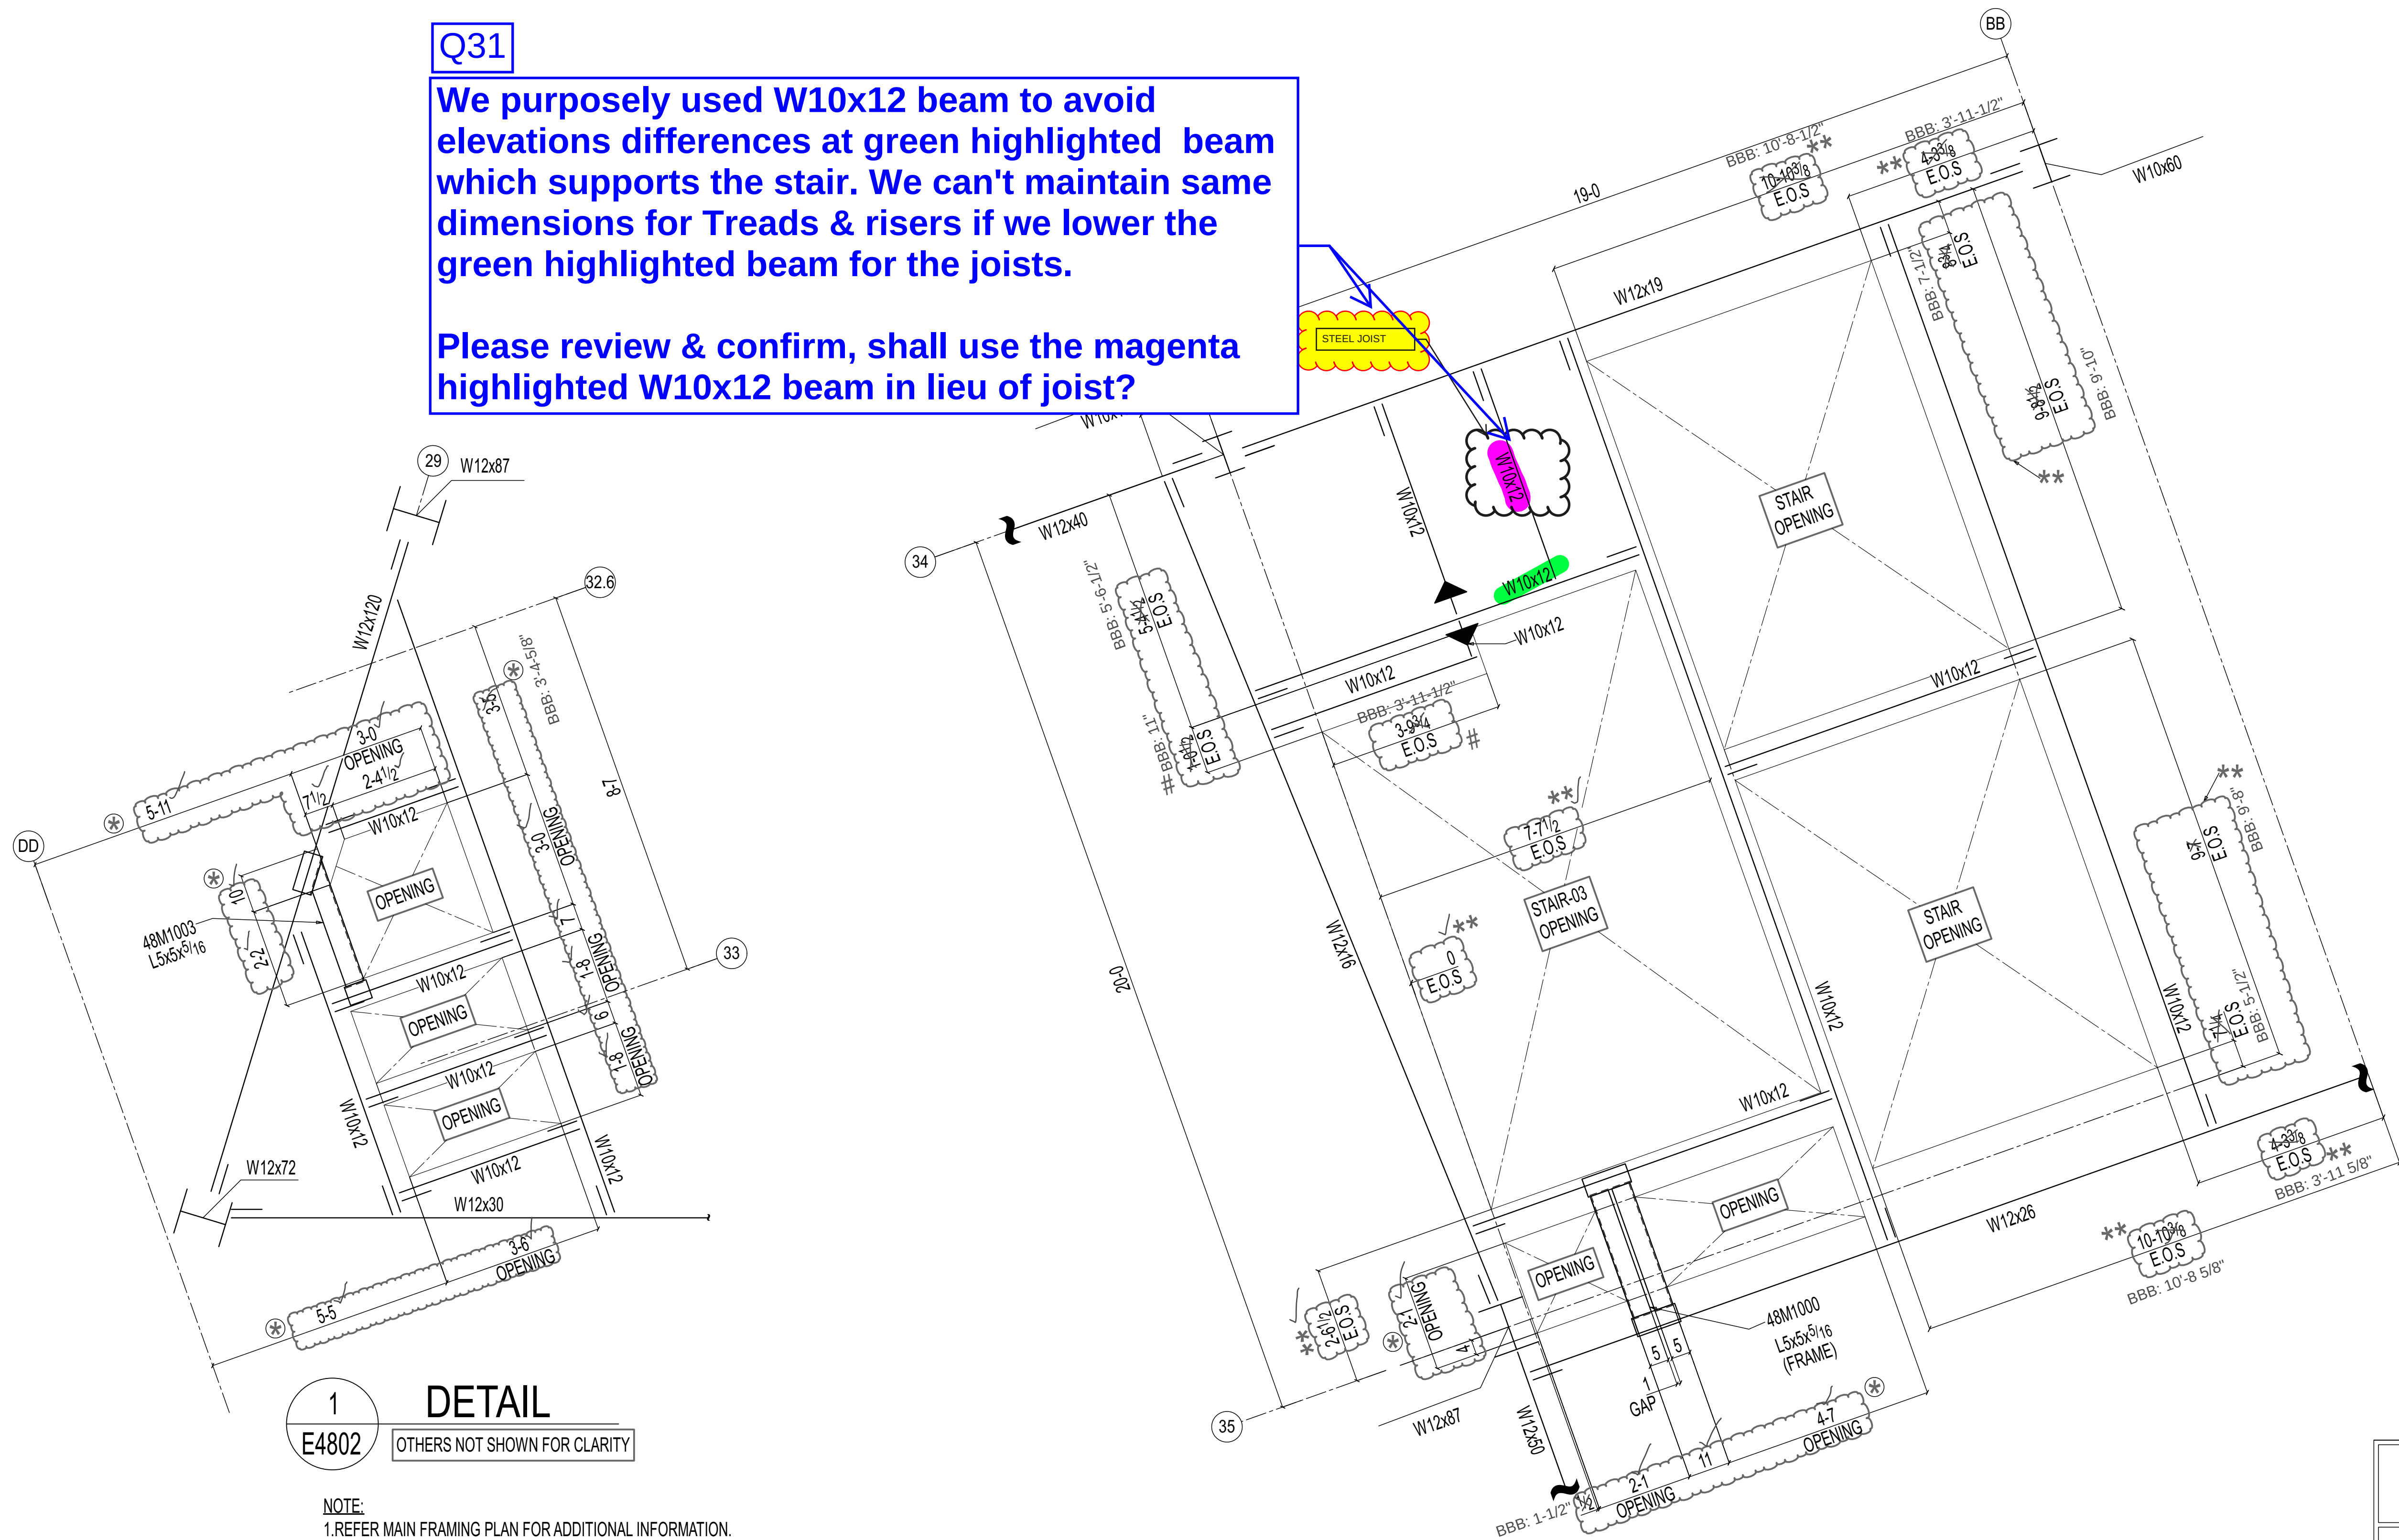

1
E4802
DETAIL
OTHERS NOT SHOWN FOR CLARITY

NOTE:
1.REFER MAIN FRAMING PLAN FOR ADDITIONAL INFORMATION.
2.REFER E4804 SHEET FOR TYPICAL SLAB OPENING SUPPORT DETAIL.

2
E4802
DETAIL
OTHERS NOT SHOWN FOR CLARITY

NOTE:
1.REFER MAIN FRAMING PLAN FOR ADDITIONAL INFORMATION.
2.REFER E4804 SHEET FOR TYPICAL SLAB OPENING SUPPORT DETAIL.

SEE COMMENT ON PLAN

A/E Please Confirm

ARCH. PLEASE CONFIRM

**APPROVER, PLEASE CONFIRM THE CLOUDED EDGE OF SLAB DIMENSION FOR STAIR OPENINGS ARE OK TO PROCEED?

⊕APPROVER, PLEASE CONFIRM THE CLOUDED OPENING LOCATIONS AND OPENING SIZES ARE OK TO PROCEED?


NOTE
EDGE OF SLAB DIMENSIONS NEEDS TO BE CO-ORDINATED WITH STAIR DRAWINGS.

COORD. WITH ARCH. DRAWINGS AND MEP DRAWINGS FOR OPENING LOCATIONS

REVISIONS

REV#	DWN BY	DESCRIPTION	DATE
A	MNK	ISSUED FOR APPROVAL	Apr 22 2025

THE INFORMATION NOTED HEREON THIS DRAWING IS THE PROPERTY OF STEEL FAB ENTERPRISES, INC. AND SHALL NOTED BE USED WITHOUT WRITTEN CONSENT.

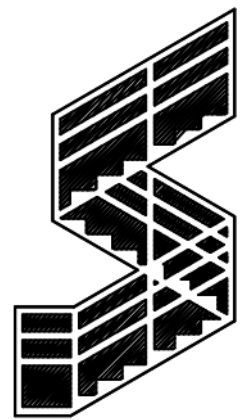

STEEL FAB
ENTERPRISES, LLC

MISCELLANEOUS METALS FABRICATOR AND ERECTORS
623 BAUMGARDNER ROAD, LANCASTER, PA 17603
TEL. (717)464-0330 FAX (717)464-9464
WWW.STEELFABENTERPRISES.COM



PROJECT OWNER : HP NAREF, 1250 MARYLAND HOLDINGS 1 LP.


PROJECT DESCRIPTION : 1250 MARYLAND AVENUE

PROJECT ADDRESS : 1250 MARYLAND AVENUE, WASHINGTON, DC 20024

CONTRACTOR : IRON FABRICATION SERVICES, INC.

DRAWN BY : JSV	DATE : 02-27-2025	PROJ. NO. : 25001	REV #
CHECKED BY : MNK	DATE : 02-27-2025	DWG NO. : E4802	△

DWG DESCRIPTION : DETAILS

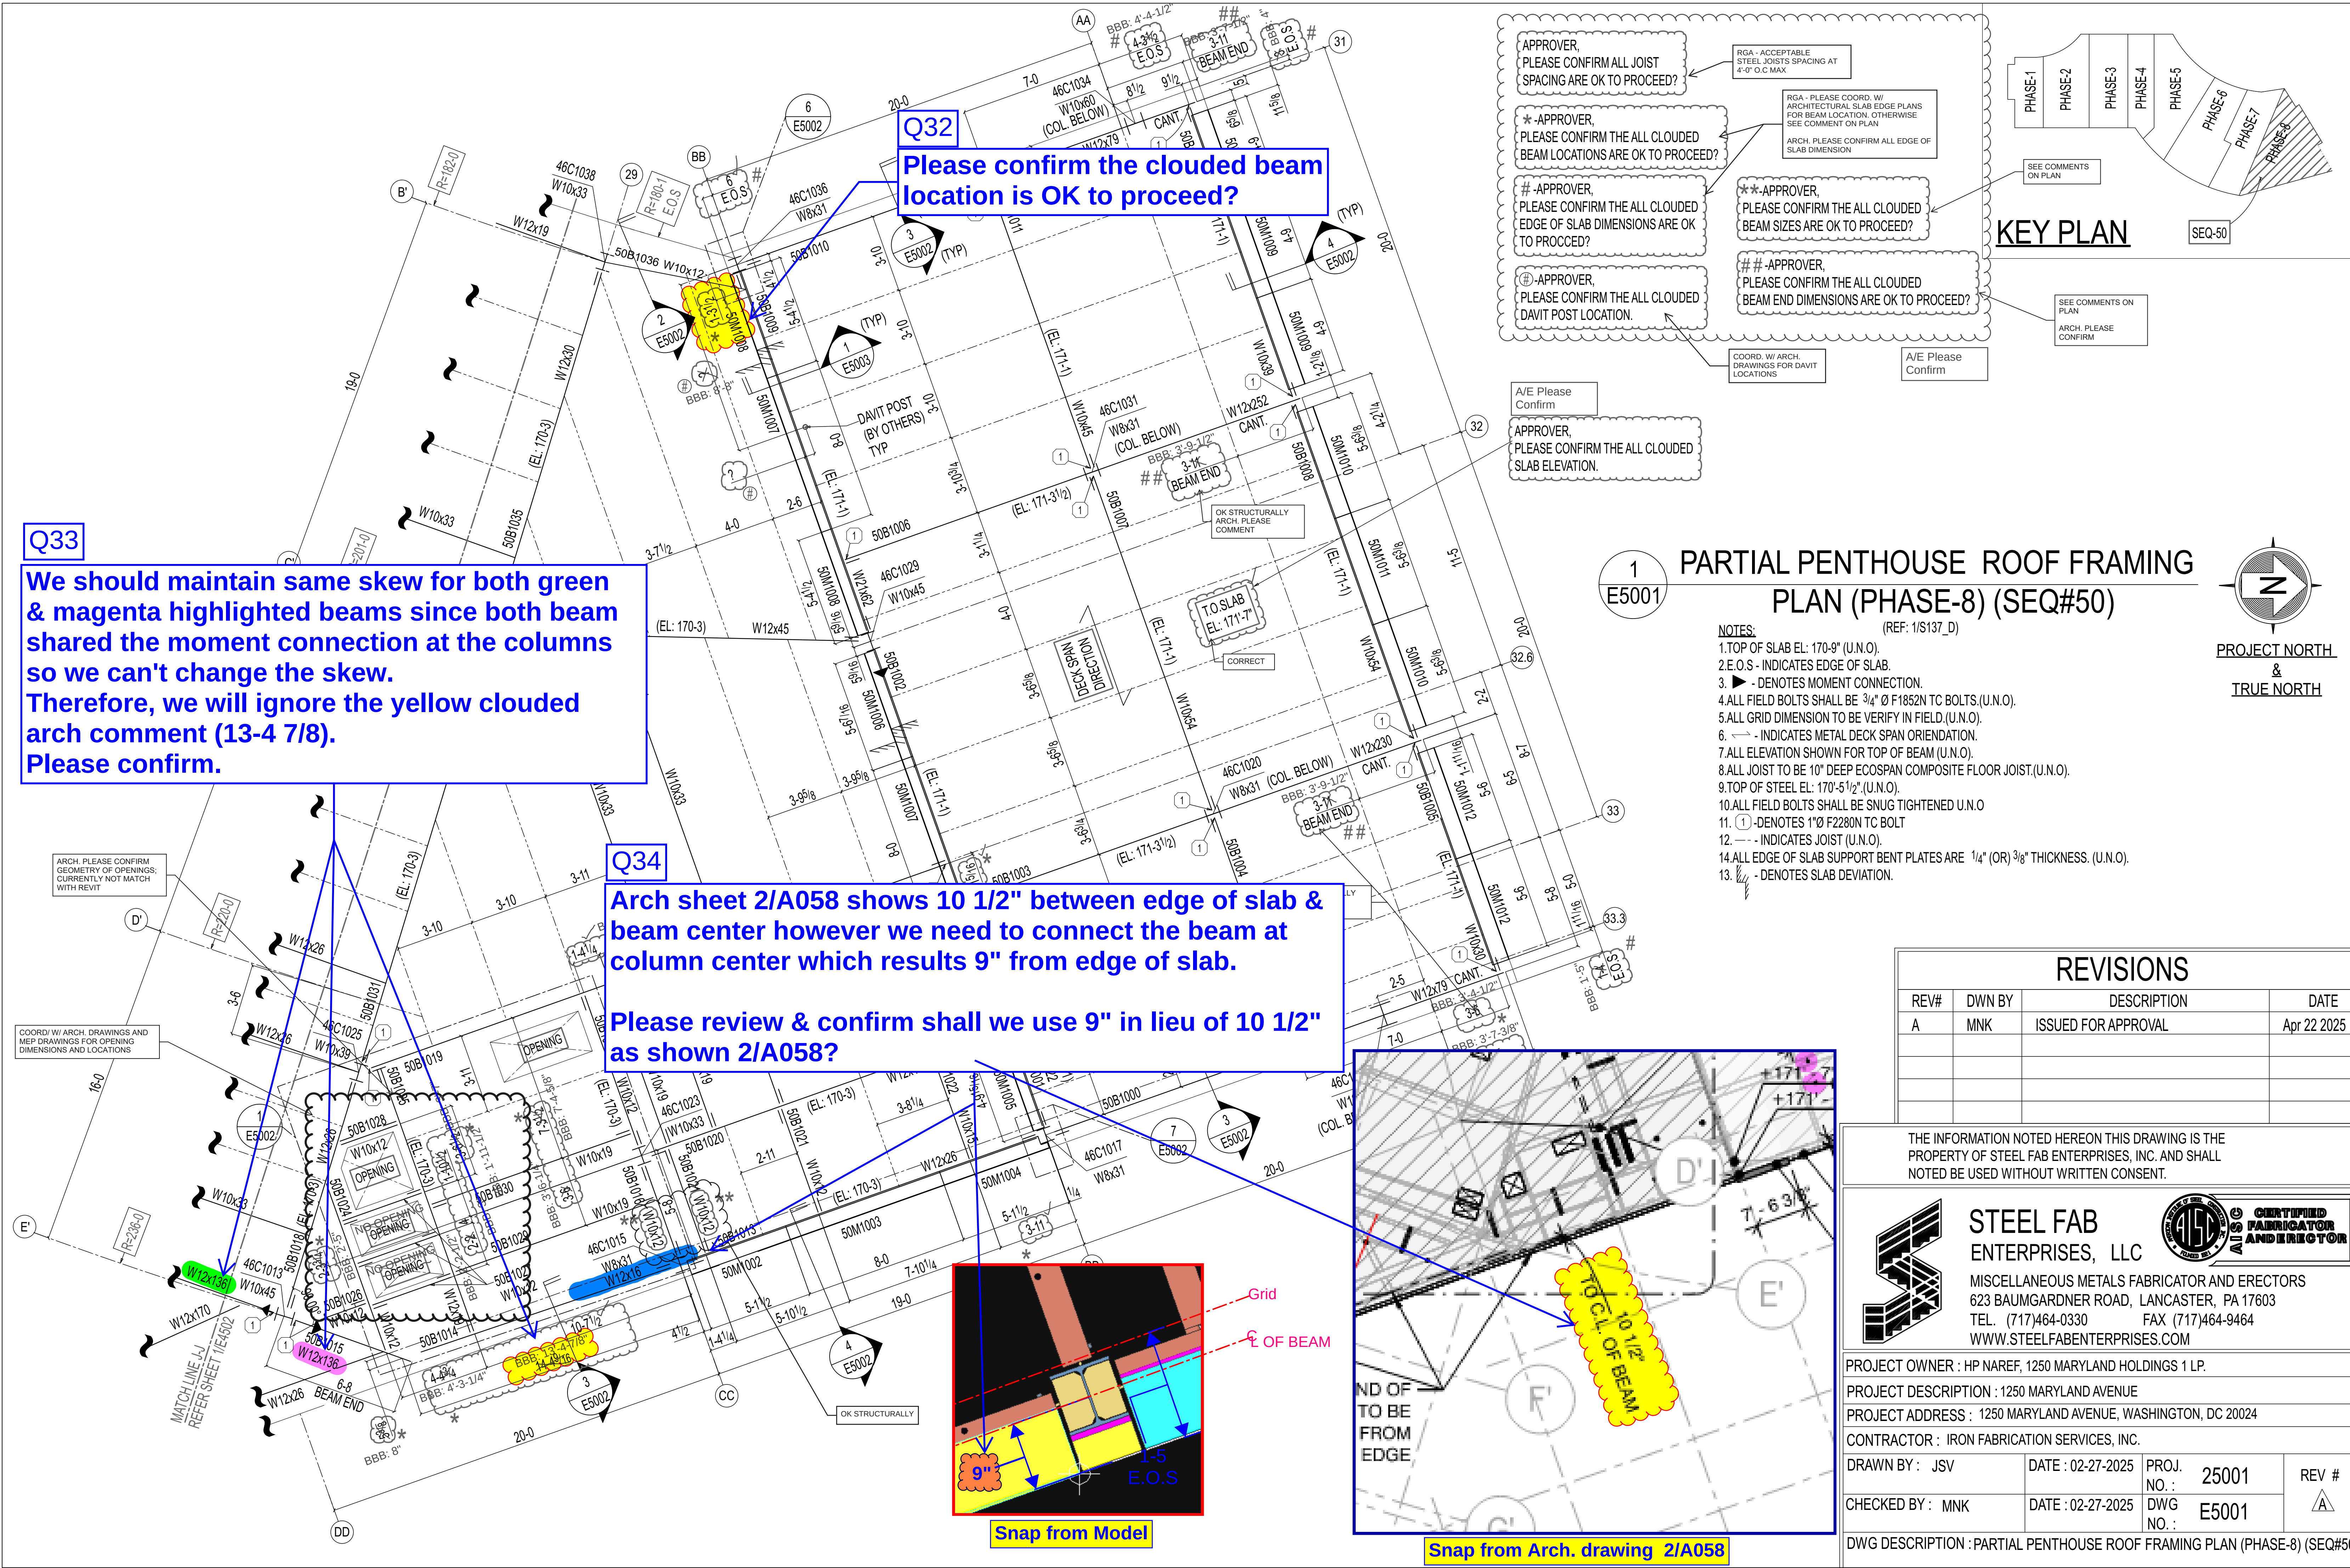

Q33

We should maintain same skew for both green & magenta highlighted beams since both beam shared the moment connection at the columns so we can't change the skew. Therefore, we will ignore the yellow clouded arch comment (13-4 7/8). Please confirm.

Q34

Arch sheet 2/A058 shows 10 1/2" between edge of slab & beam center however we need to connect the beam at column center which results 9" from edge of slab.

Please review & confirm shall we use 9" in lieu of 10 1/2" as shown 2/A058?

Q32

Please confirm the clouded beam location is OK to proceed?

APPROVER, PLEASE CONFIRM ALL JOIST SPACING ARE OK TO PROCEED?

*-APPROVER, PLEASE CONFIRM THE ALL CLOUDED BEAM LOCATIONS ARE OK TO PROCEED?

#-APPROVER, PLEASE CONFIRM THE ALL CLOUDED EDGE OF SLAB DIMENSIONS ARE OK TO PROCEED?

Ⓜ-APPROVER, PLEASE CONFIRM THE ALL CLOUDED DAVIT POST LOCATION.

APPROVER, PLEASE CONFIRM THE ALL CLOUDED SLAB ELEVATION.

RG- ACCEPTABLE STEEL JOISTS SPACING AT 4'-0" O.C MAX

RG- PLEASE COORD. W/ ARCHITECTURAL SLAB EDGE PLANS FOR BEAM LOCATION, OTHERWISE SEE COMMENT ON PLAN

ARCH. PLEASE CONFIRM ALL EDGE OF SLAB DIMENSION

**APPROVER, PLEASE CONFIRM THE ALL CLOUDED BEAM SIZES ARE OK TO PROCEED?


##-APPROVER, PLEASE CONFIRM THE ALL CLOUDED BEAM END DIMENSIONS ARE OK TO PROCEED?

COORD. W/ ARCH. DRAWINGS FOR DAVIT LOCATIONS

A/E Please Confirm

SEE COMMENTS ON PLAN


ARCH. PLEASE CONFIRM

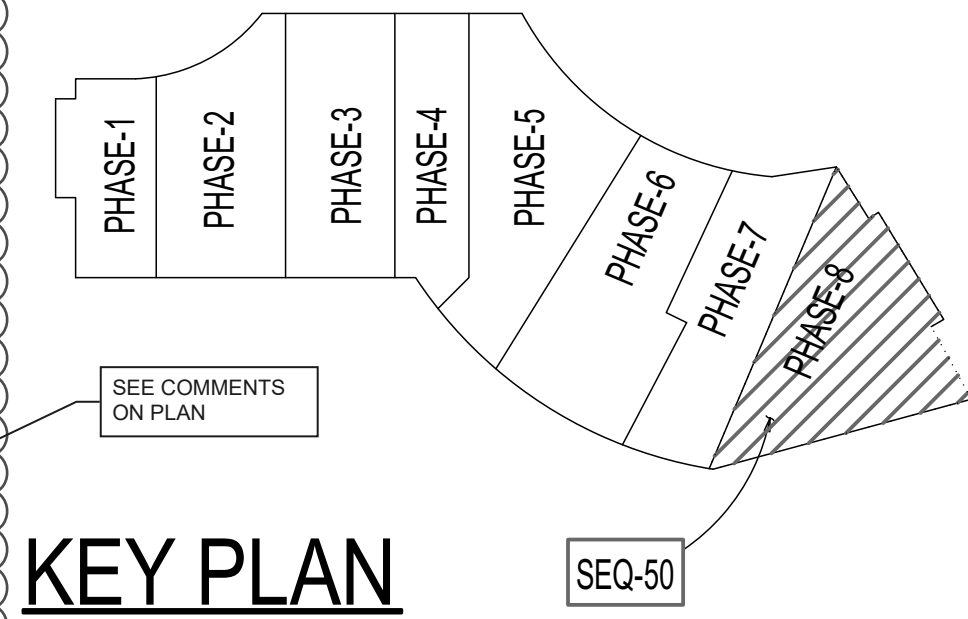

1 PARTIAL PENTHOUSE ROOF FRAMING PLAN (PHASE-8) (SEQ#50)

(REF: 1/S137_D)

- NOTES:
- 1.TOP OF SLAB EL: 170'-9" (U.N.O).
 - 2.E.O.S - INDICATES EDGE OF SLAB.
 3. ► - DENOTES MOMENT CONNECTION.
 - 4.ALL FIELD BOLTS SHALL BE 3/4" Ø F1852N TC BOLTS.(U.N.O).
 - 5.ALL GRID DIMENSION TO BE VERIFY IN FIELD.(U.N.O).
 6. ← - INDICATES METAL DECK SPAN ORIENTATION.
 - 7.ALL ELEVATION SHOWN FOR TOP OF BEAM (U.N.O).
 - 8.ALL JOIST TO BE 10" DEEP ECOSPAN COMPOSITE FLOOR JOIST.(U.N.O).
 - 9.TOP OF STEEL EL: 170'-5 1/2" (U.N.O).
 - 10.ALL FIELD BOLTS SHALL BE SNUG TIGHTENED U.N.O
 11. ① -DENOTES 1"Ø F2280N TC BOLT
 12. --- INDICATES JOIST (U.N.O).
 - 14.ALL EDGE OF SLAB SUPPORT BENT PLATES ARE 1/4" (OR) 3/8" THICKNESS. (U.N.O).
 13. ⚡ - DENOTES SLAB DEVIATION.

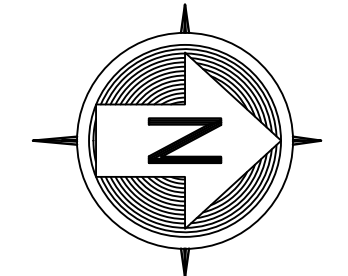

PROJECT NORTH & TRUE NORTH

REVISIONS

REV#	DWN BY	DESCRIPTION	DATE
A	MNK	ISSUED FOR APPROVAL	Apr 22 2025

THE INFORMATION NOTED HEREON THIS DRAWING IS THE PROPERTY OF STEEL FAB ENTERPRISES, INC. AND SHALL NOTED BE USED WITHOUT WRITTEN CONSENT.



STEEL FAB ENTERPRISES, LLC

MISCELLANEOUS METALS FABRICATOR AND ERECTORS


623 BAUMGARDNER ROAD, LANCASTER, PA 17603

TEL. (717)464-0330 FAX (717)464-9464

WWW.STEELFABENTERPRISES.COM

CERTIFIED FABRICATOR AND DIRECTOR

PROJECT OWNER : HP NAREF, 1250 MARYLAND HOLDINGS 1 LP.			
PROJECT DESCRIPTION : 1250 MARYLAND AVENUE			
PROJECT ADDRESS : 1250 MARYLAND AVENUE, WASHINGTON, DC 20024			
CONTRACTOR : IRON FABRICATION SERVICES, INC.			
DRAWN BY : JSV	DATE : 02-27-2025	PROJ. NO. : 25001	REV # A
CHECKED BY : MNK	DATE : 02-27-2025	DWG NO. : E5001	
DWG DESCRIPTION : PARTIAL PENTHOUSE ROOF FRAMING PLAN (PHASE-8) (SEQ#50)			

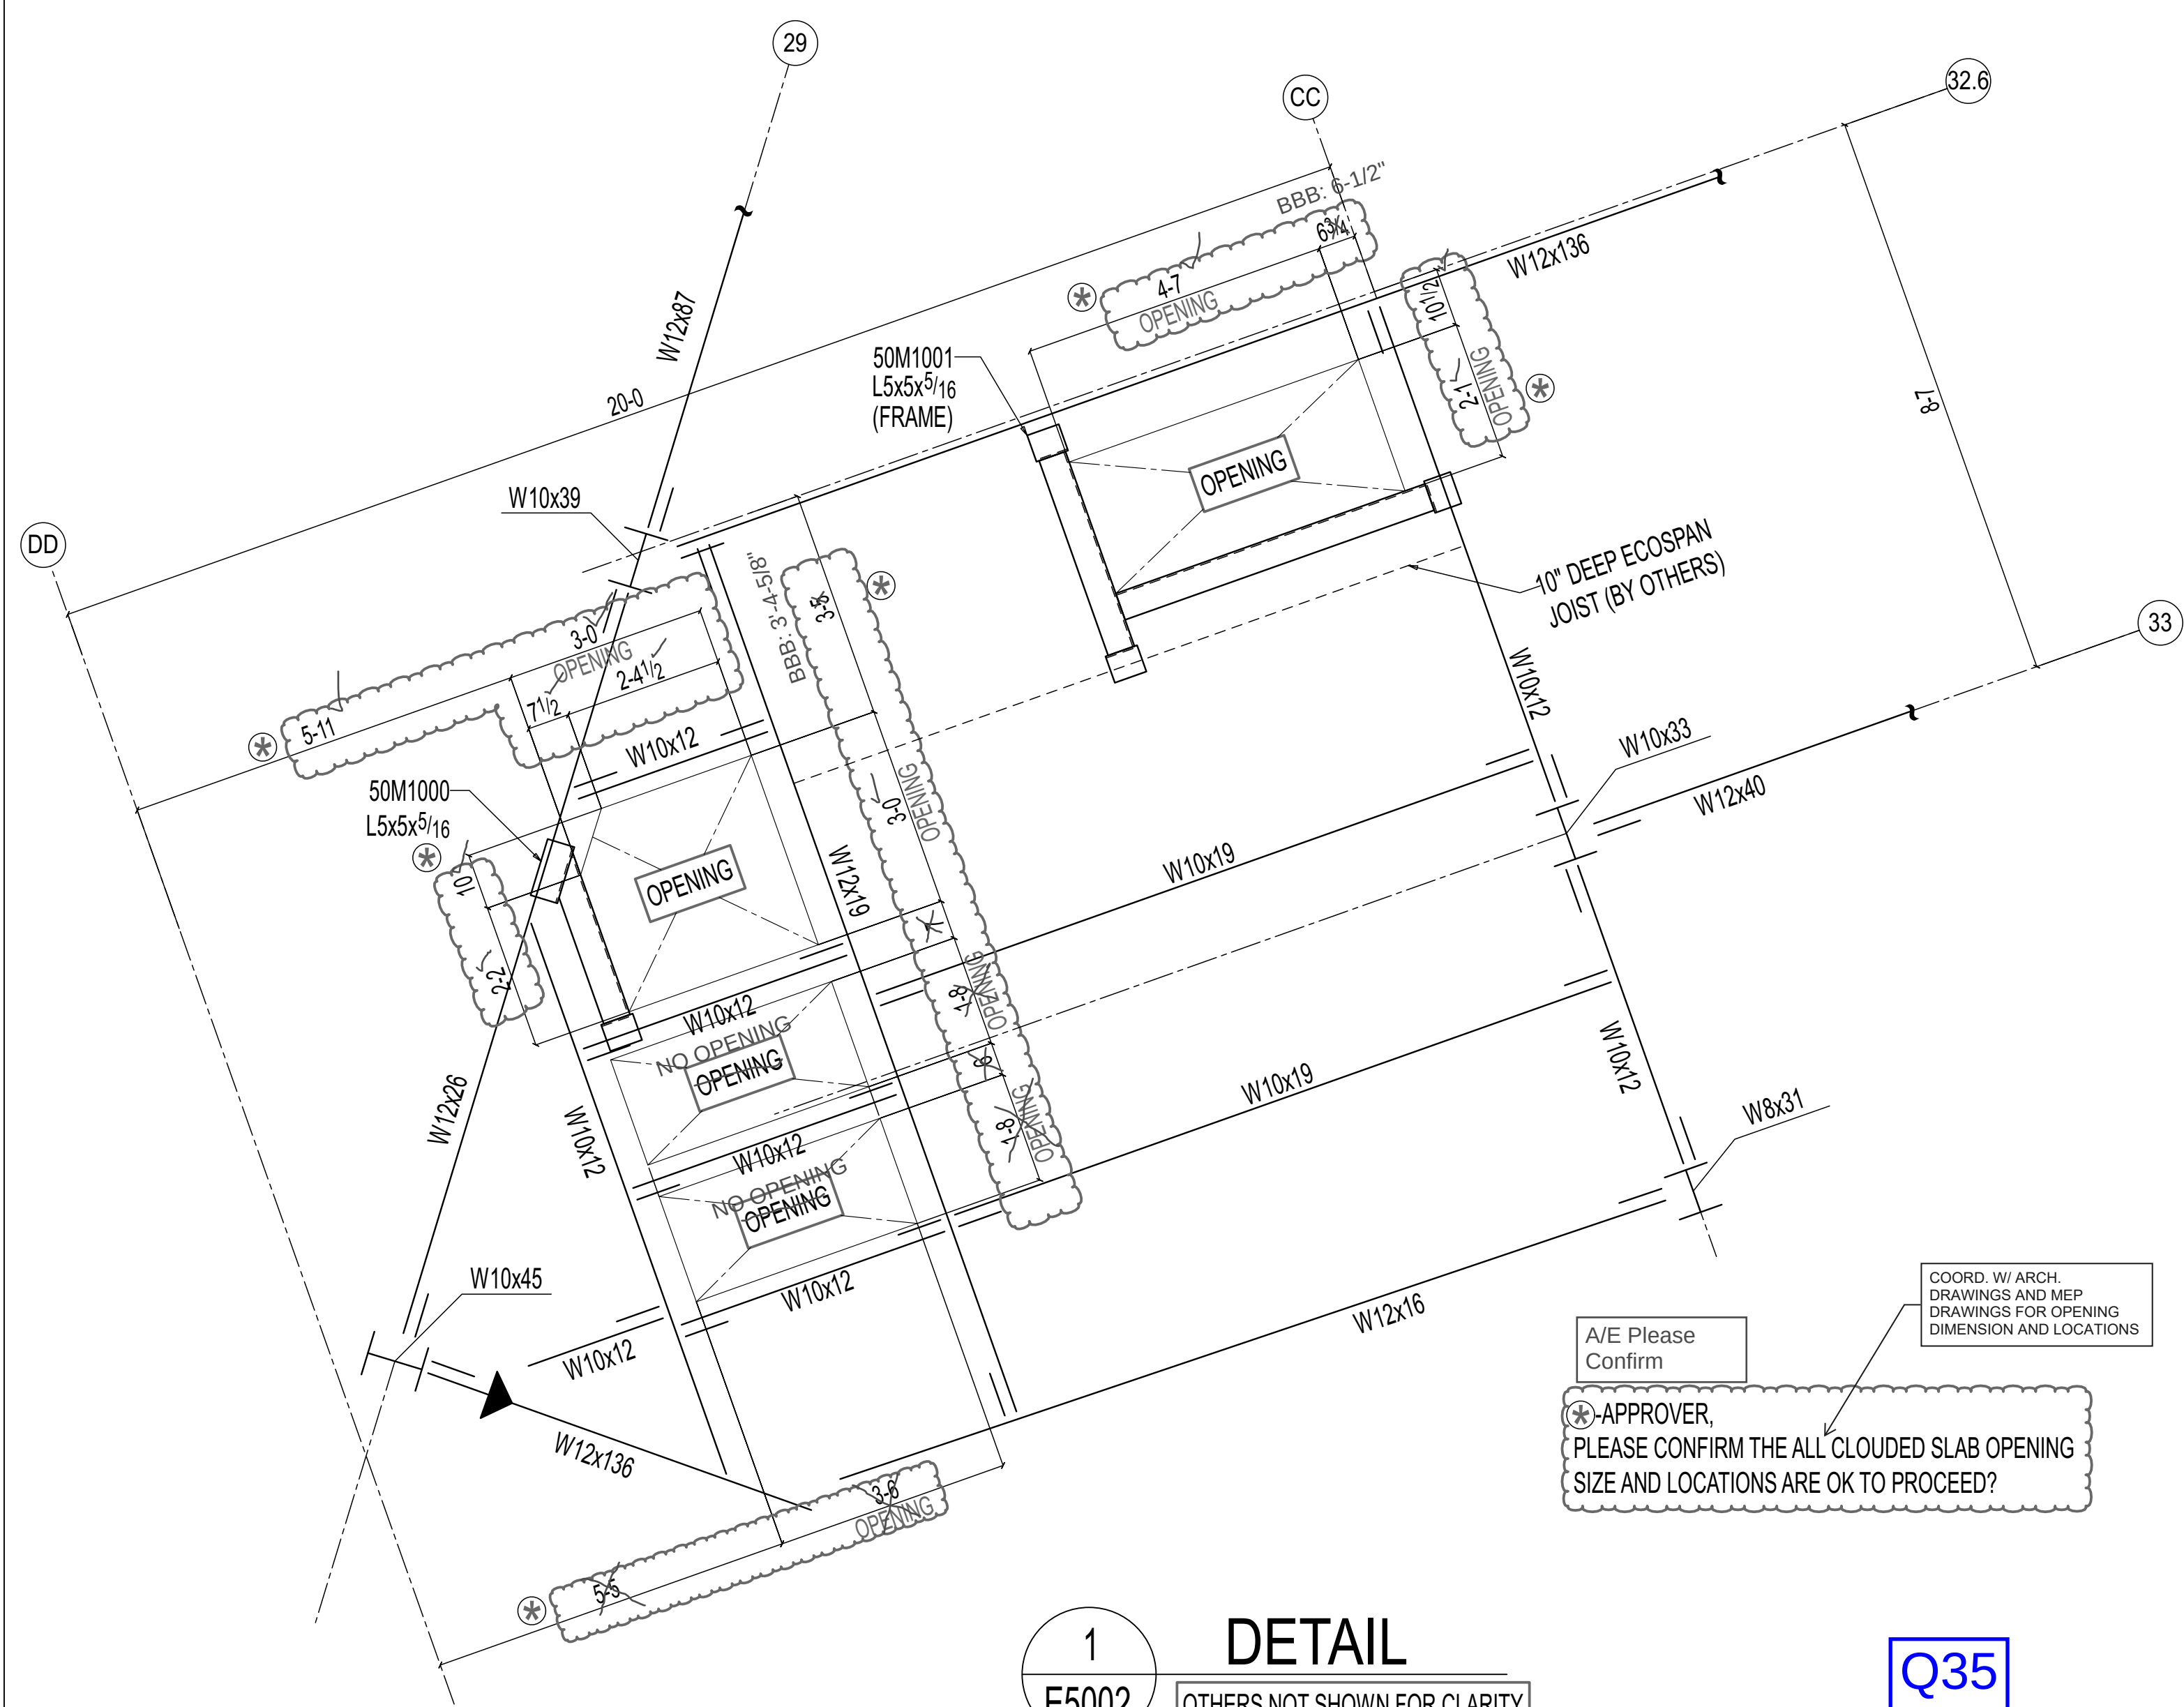


1
E5002
DETAIL
OTHERS NOT SHOWN FOR CLARITY

NOTE:
1.REFER MAIN FRAMING PLAN FOR ADDITIONAL INFORMATION.
2.REFER E5003 SHEET FOR TYPICAL SLAB OPENING SUPPORT DETAIL.


Q35

**Arch,
Please confirm the clouded
edge of slab dimension is OK to
proceed?**

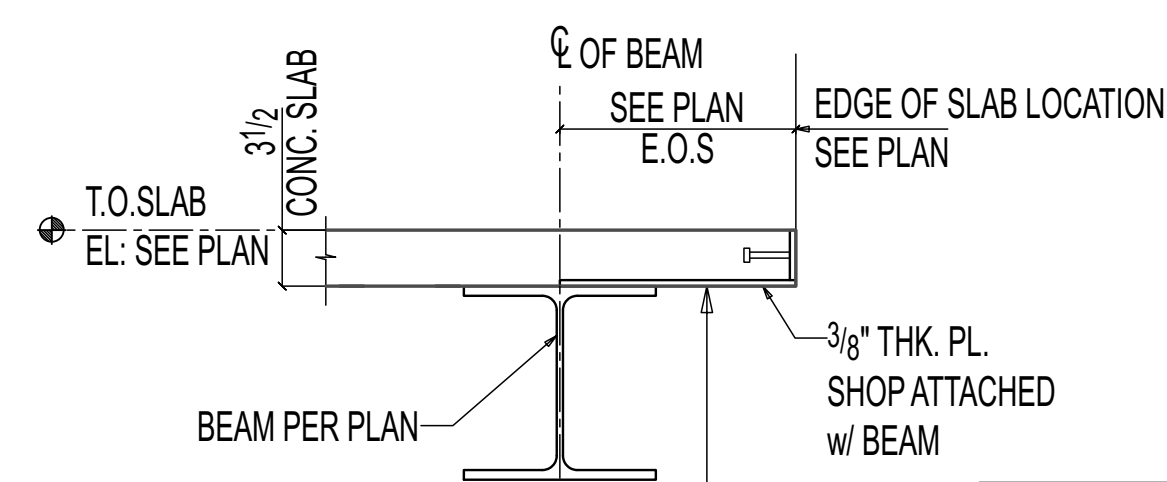

ERECTOR NOTE:
BEAM AND BENT PLATE
MAY REQUIRE TEMPORARY ERECTION
SUPPORT. SUPPORT TO REMAIN IN
PLACE UNTIL CONCRETE SLAB HAVE
BEEN PLACED AND THE CONCRETE HAS
OBTAINED DESIGN STRENGTH.

2
SECTION

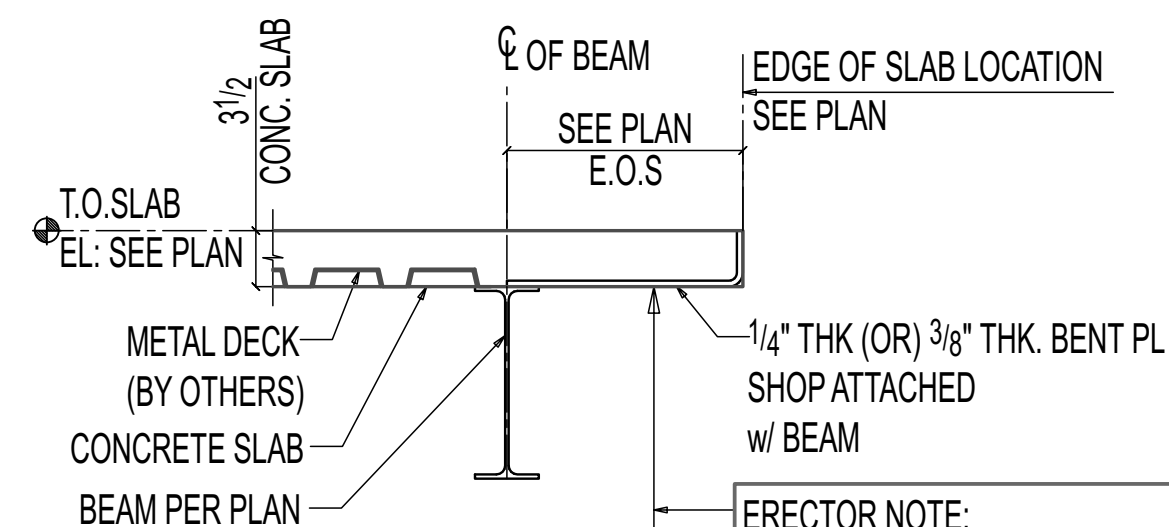

ERECTOR NOTE:
BEAM AND BENT PLATE
MAY REQUIRE TEMPORARY ERECTION
SUPPORT. SUPPORT TO REMAIN IN
PLACE UNTIL CONCRETE SLAB HAVE
BEEN PLACED AND THE CONCRETE HAS
OBTAINED DESIGN STRENGTH.

3
E5002
SECTION

(REF: 03/S306)

REVISIONS

REV#	DWN BY	DESCRIPTION	DATE
A	MNK	ISSUED FOR APPROVAL	Apr 22 2025

THE INFORMATION NOTED HEREON THIS DRAWING IS THE
PROPERTY OF STEEL FAB ENTERPRISES, INC. AND SHALL
NOTED BE USED WITHOUT WRITTEN CONSENT.



**STEEL FAB
ENTERPRISES, LLC**



MISCELLANEOUS METALS FABRICATOR AND ERECTORS
623 BAUMGARDNER ROAD, LANCASTER, PA 17603
TEL. (717)464-0330 FAX (717)464-9464
WWW.STEELFABENTERPRISES.COM

PROJECT OWNER : HP NAREF, 1250 MARYLAND HOLDINGS 1 LP.


PROJECT DESCRIPTION : 1250 MARYLAND AVENUE

PROJECT ADDRESS : 1250 MARYLAND AVENUE, WASHINGTON, DC 20024


CONTRACTOR : IRON FABRICATION SERVICES, INC.

DRAWN BY : JSV	DATE : 02-27-2025	PROJ. NO. : 25001	REV #
CHECKED BY : MNK	DATE : 02-27-2025	DWG NO. : E5002	⚠


DWG DESCRIPTION : DETAILS & SECTIONS

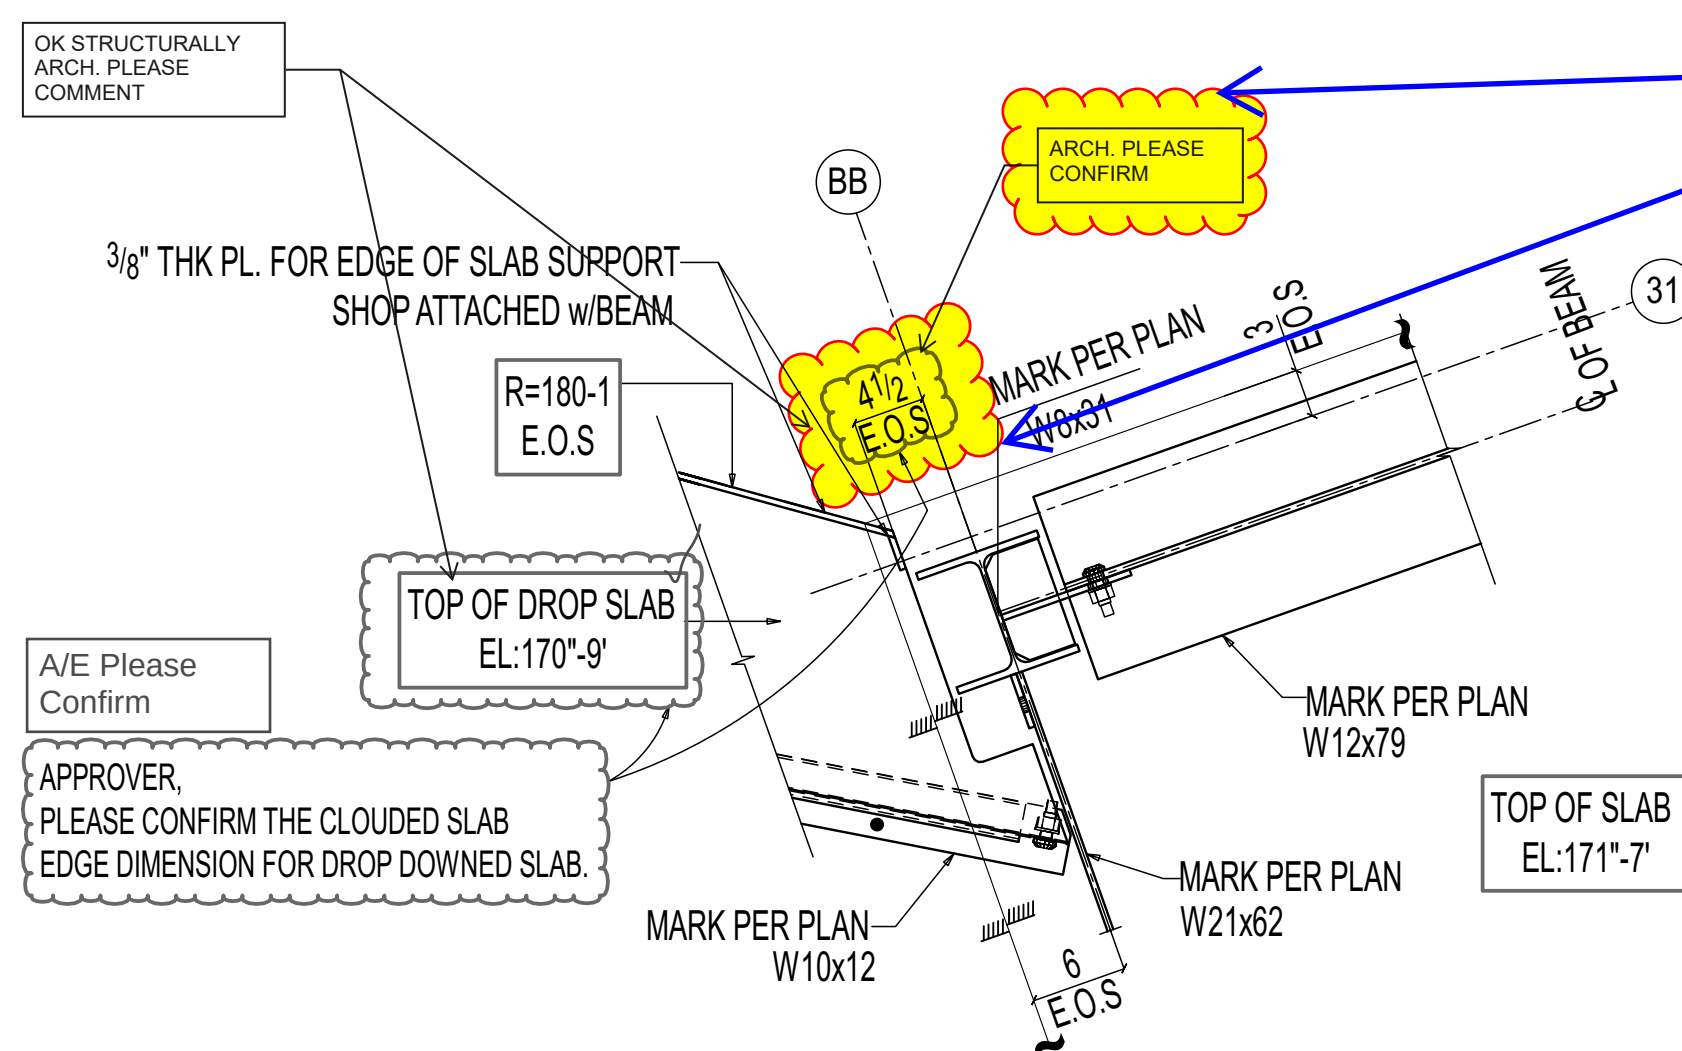

6
E5002
DETAIL
(OTHERS NOT SHOWN FOR CLARITY)

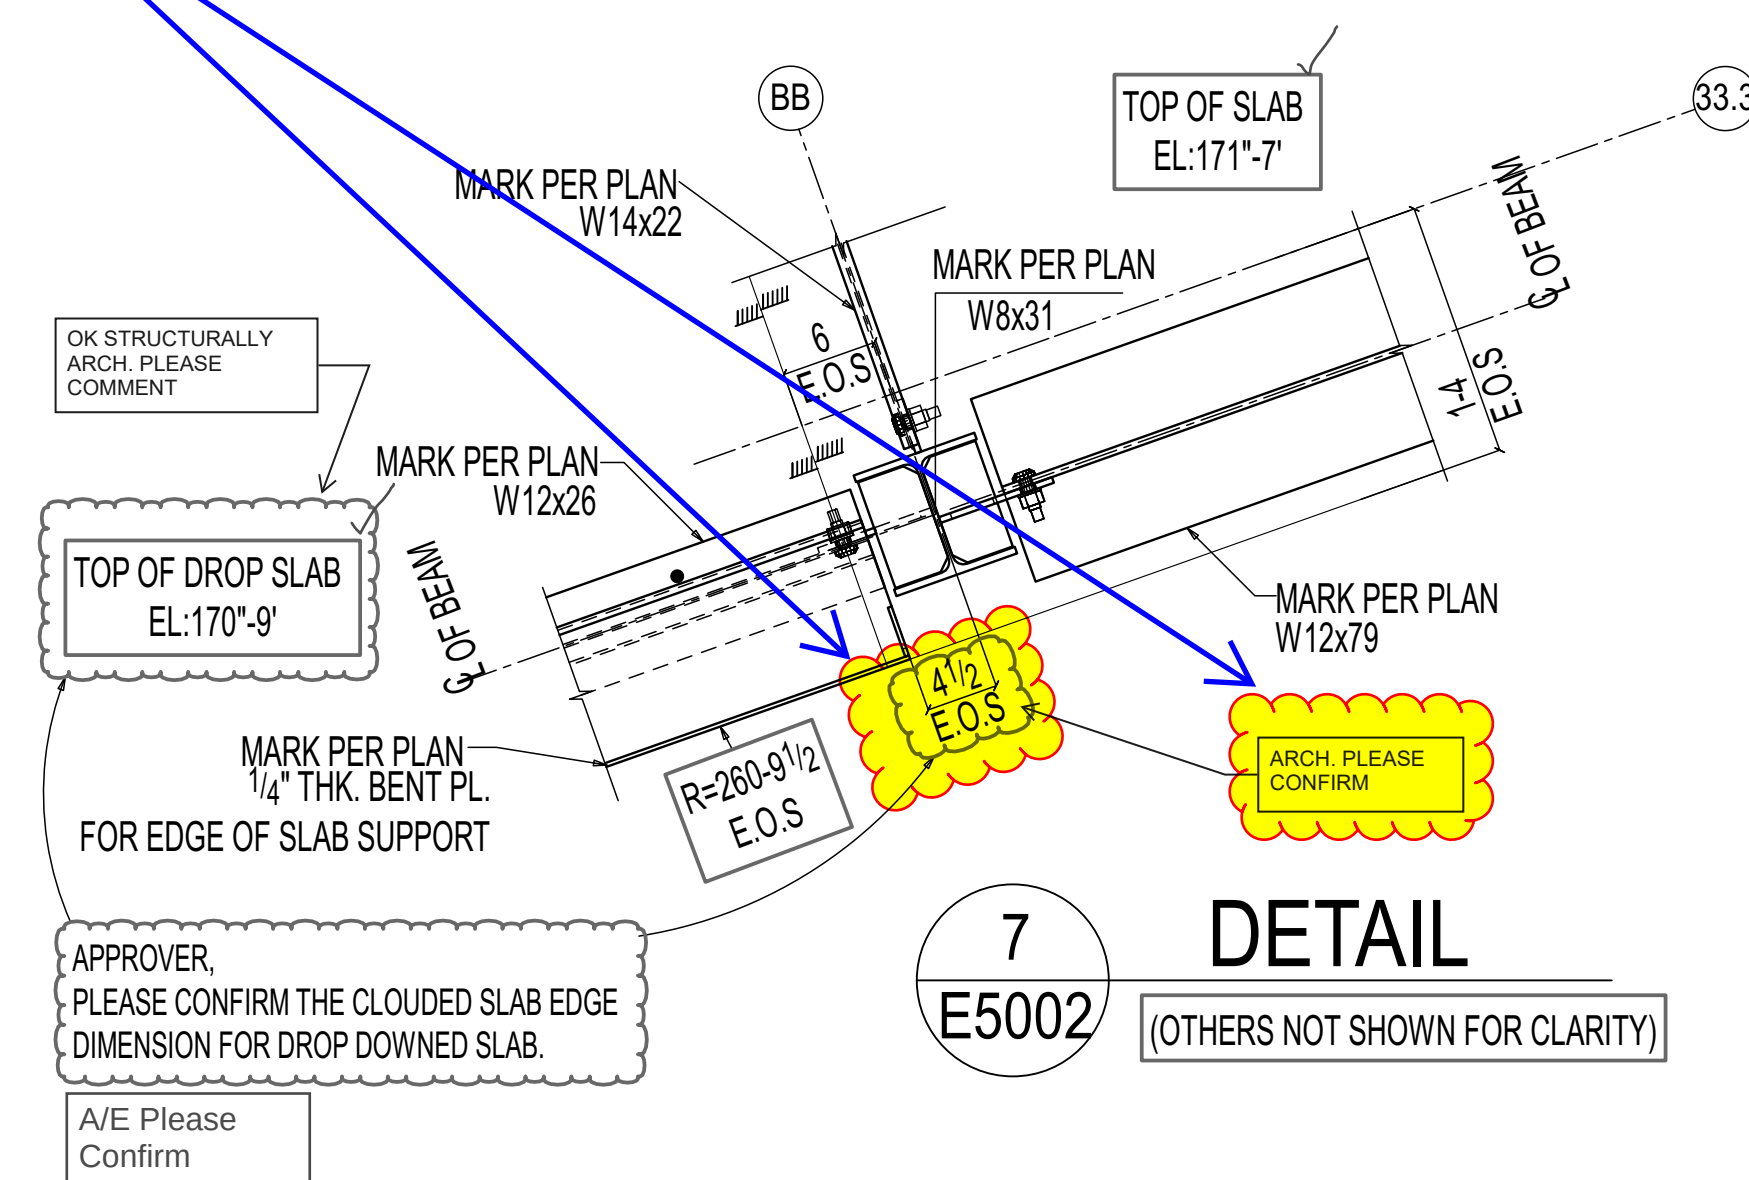

7
E5002
DETAIL
(OTHERS NOT SHOWN FOR CLARITY)

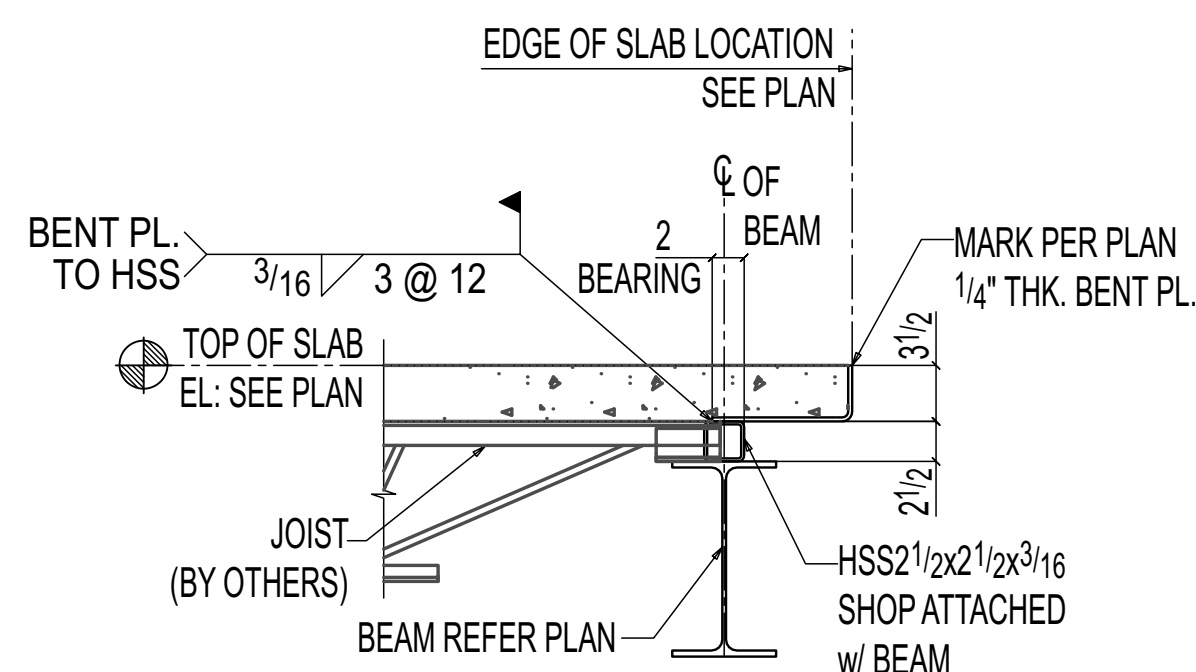

4
E5002
SECTION
(REF: 3/S306 SIM)