1 SE705 ELEVATION VIEW

(REF: 15/A380)

OTHER NOT SHOWN FOR CLARITY

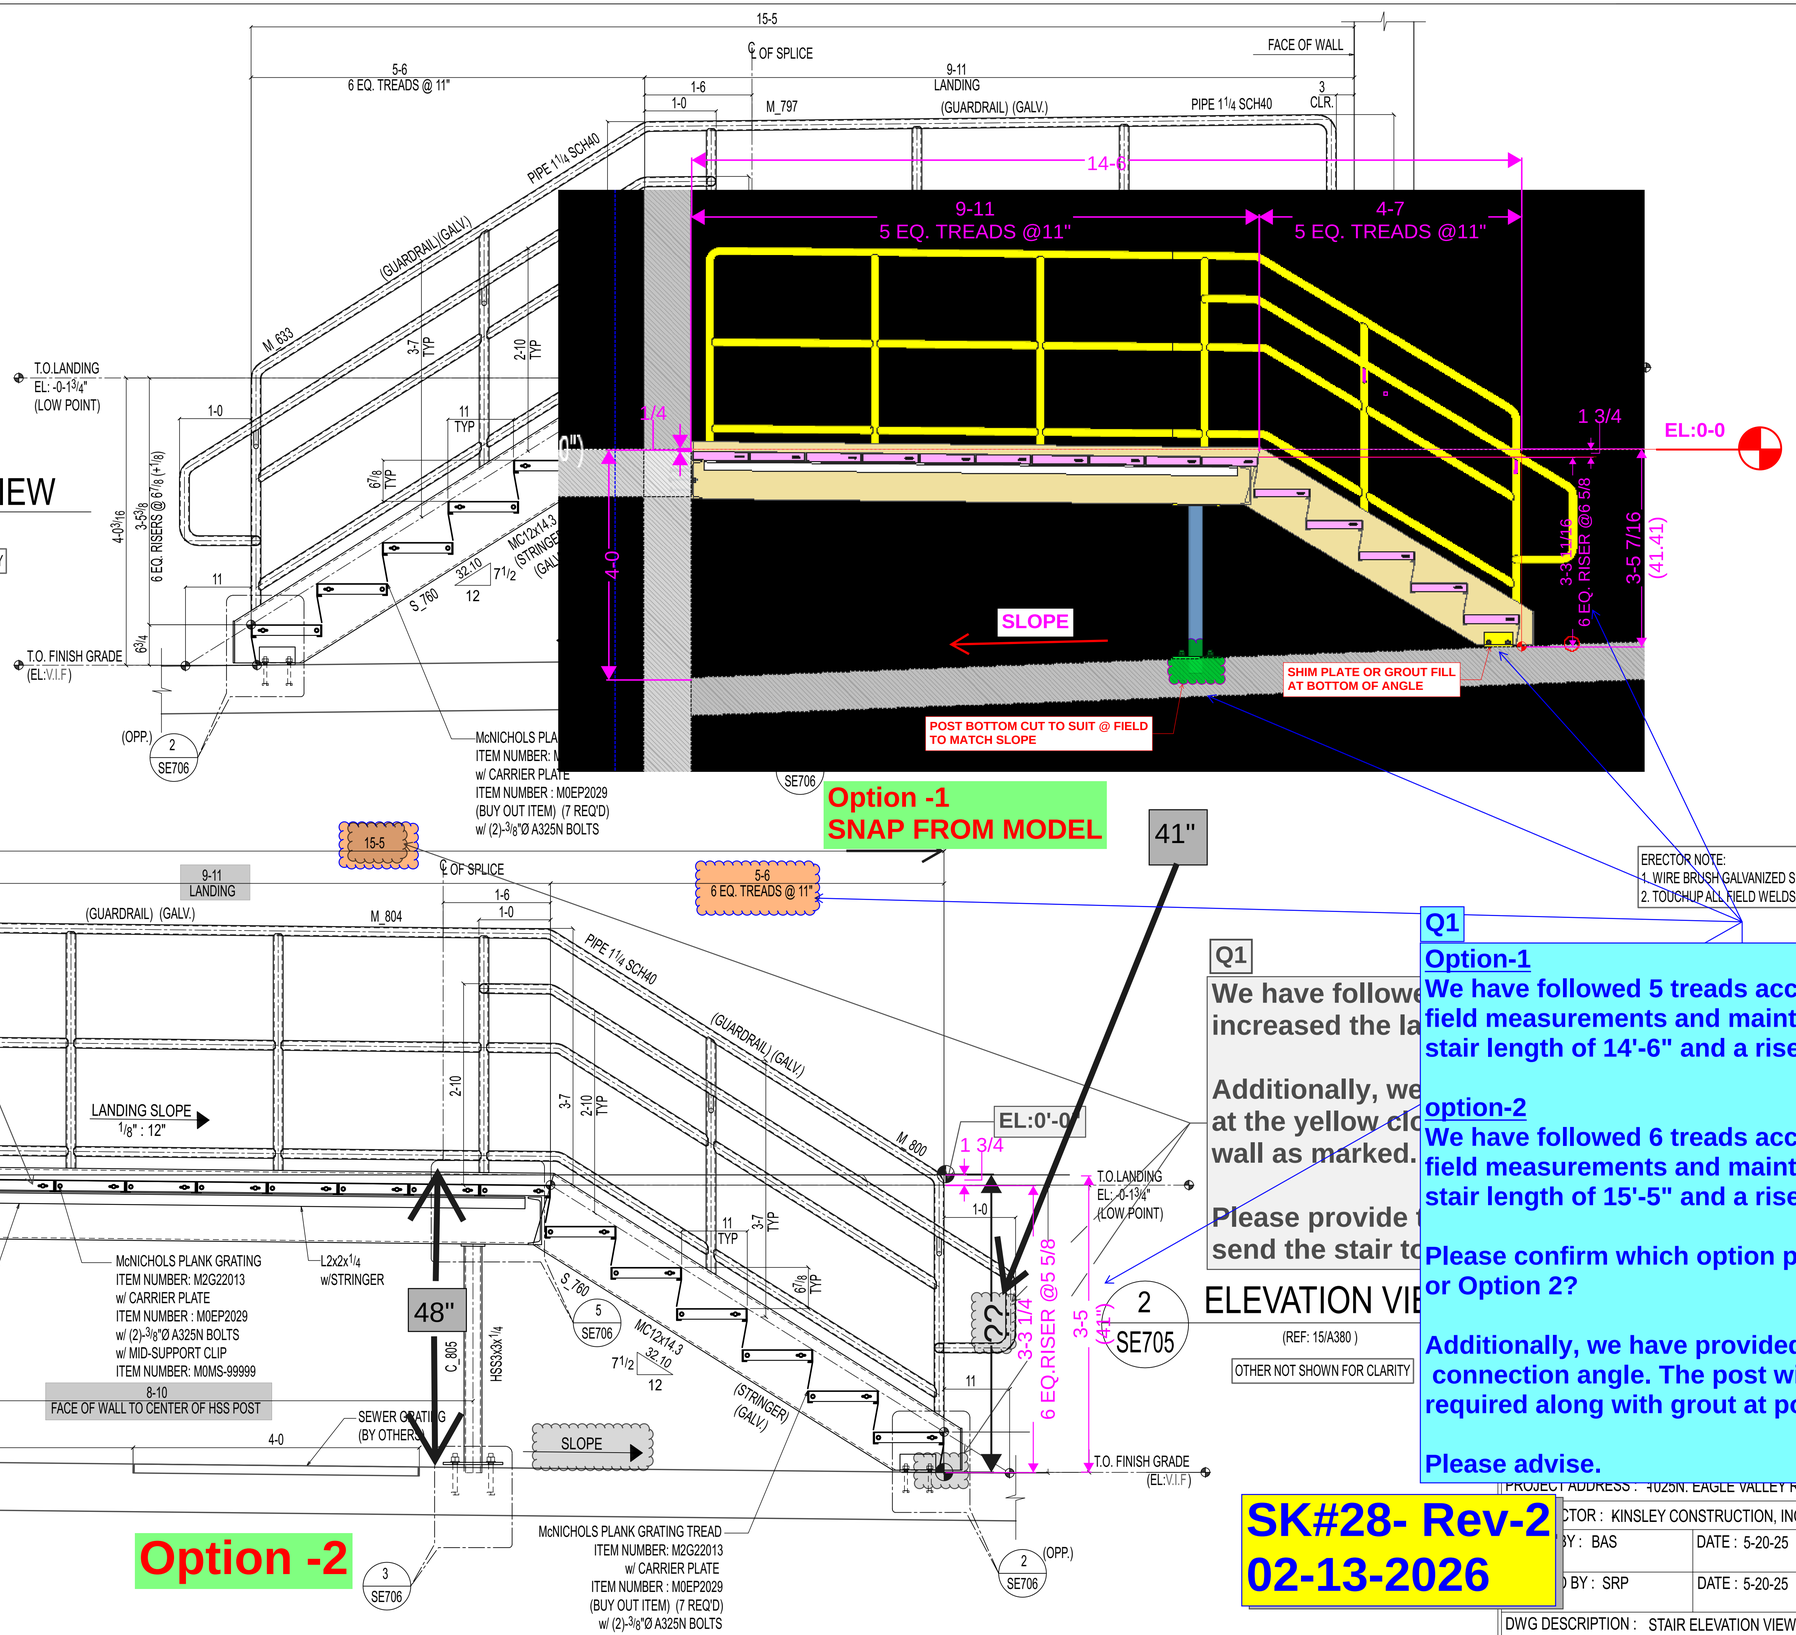

Q1

We have followe
increased the la

Additionally, we
at the yellow clo
wall as marked.

Please provide t
send the stair to

ELEVATION VIE

(REF: 15/A380)

OTHER NOT SHOWN FOR CLARITY

Q1

Option-1

We have followed 5 treads according to the given field measurements and maintained an overall dock stair length of 14'-6" and a riser height of 6 5/8".

option-2

We have followed 6 treads according to the given field measurements and maintained an overall dock stair length of 15'-5" and a riser height of 5 5/8".

Please confirm which option preferable? Option 1 or Option 2?

Additionally, we have provided grout at the bottom connection angle. The post will be field-cut as required along with grout at post baseplate.

Please advise.

SK#28- Rev-2
02-13-2026

PROJECT ADDRESS : 4025N. EAGLE VALLEY ROAD, HOWARD, PA 16841

CTOR : KINSLEY CONSTRUCTION, INC.

BY : BAS	DATE : 5-20-25	PROJ. NO. : 25012	REV # A
D BY : SRP	DATE : 5-20-25	DWG NO. : SE705	

DWG DESCRIPTION : STAIR ELEVATION VIEW